

**SURVEY & REMONUMENTATION**

**FEB 24 1998**

**LAND CORNER RECORDATION CERTIFICATE**  
Filing Requirement of Act 74, Mich. P.A. 1970

**FILED**

For corners in **SECTION**

LIVINGSTON

(County)

Located In:

Corner Code #

- 1. Public Land Survey      T 3N R 3E      B-13  
    T \_\_\_\_\_ R \_\_\_\_\_  
    T \_\_\_\_\_ R \_\_\_\_\_  
    T \_\_\_\_\_ R \_\_\_\_\_
- 2. Property Controlling      S \_\_\_\_\_ T \_\_\_\_\_ R \_\_\_\_\_  
   in Section                    S \_\_\_\_\_ T \_\_\_\_\_ R \_\_\_\_\_
- 3. Miscellaneous            S \_\_\_\_\_ T \_\_\_\_\_ R \_\_\_\_\_  
   Property in Sec.            S \_\_\_\_\_ T \_\_\_\_\_ R \_\_\_\_\_

1997 AUG 27 P 12:32

NANCY HAVILAND  
REGISTER OF DEEDS  
LIVINGSTON COUNTY, MI.  
48843

L.S.C. #690m

Register of Deeds Stamp & File Number

- 4. Lot No. \_\_\_\_\_, Recorded Plat \_\_\_\_\_
- 5. Private Claims \_\_\_\_\_

I, CHARLES E. GARLOCK, in a field survey on AUG. 8, 1997 do hereby state that under requirements of P.A. 74, Michigan P.A. of 1970, the corner points mentioned in lines 1 and 2 above were in conformance with regulations and rules therefore as required in the current manual of survey instructions of the United States Department of the Interior, Bureau of Land Management or by a decree of a Court of Law and /or that the corner points mentioned in lines 3, 4 and 5 above were in conformance with the rules of the Michigan Board of Land Surveyors or by a Decree of a Court of Law; established, re-established, monumented, recovered, found as expressed below:

**NOTE:** Not more than 2 corners, all in the same town and range, may be recorded on this certificate.

	A	B	C	D	E	F	G	H	I	J	K	L	M
1													
2	6		5		4		3		2		1		
3													
4	7		8		9		10		11		12		
5													
6	18		17		16		15		14		13		
7													
8	19		20		21		22		23		24		
9													
10	30		29		28		27		26		25		
11													
12	31		32		33		34		35		36		
13													

**A. Description of original monument and accessories and/or subsequent restoration:**

GLO SURVEY DATED APRIL 15, 1825 BY S SIBLEY AND NONE OF THE GLO WITNESSES REMAIN  
 GLO WITNESSES: WO 8-S18W-22 LKS  
 WO 22-N29W-44 LKS

**ADDITIONAL HISTORICAL DATA ON REAR OF SHEET**


**B. Description of corner evidence found and/or method applied in restoring or reestablishing corner:**

FOUND PK SPIKE AND D HUGHES WASHER, SET BY D HUGHES, ON LINE WITH THE SECTION CORNERS AND AT A PRORATED DISTANCE FOR THE CLOSING 1/2 MILE AND FIRST 1/2 MILE AS PER GLO NOTES. NO OCCUPATION TO THE NORTH.

**C. Description of monument for corner and accessories established to perpetuate locating the position of the corner:**

B-13: S 1/4 COR. SEC. 31 T3N-R3E, HANDY TWP. LIV. CO. MI., RESET ABOVE WITH 1 1/4" X 36" BREAKAWAY I. PIPE WITH LIV. CO. REMON BRASS CAP ON TOP SET AT -0.5' IN A SET MON. BOX.  
 N39W-45.32'-SP & TAG NE/S 12" ELM  
 S24W-22.55'-SP & TAG W/S 14" MAPLE  
 S44E-35.41'-SP & TAG N/S 14" MAPLE  
 S66E-131.88'-SP & TAG N/S 40" OAK  
 NORTH-6'-C/L MASON ROAD.

Signed by Charles E. Garlock Date AUGUST 23, 1997  
 Surveyor's Michigan License No. 14762

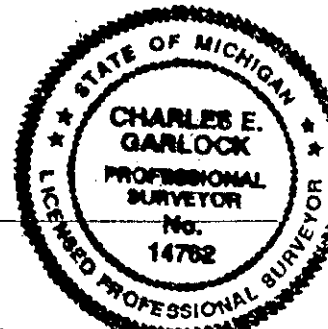

PA. 345 1880, APPROVED BY LIVINGSTON COUNTY  
 PEER GROUP ON 2/26/97 CO. REP JED

"Be Sure of Your Ground"

BY THE STATE OF MICHIGAN

**CHARLES E. GARLOCK**

PROFESSIONAL SURVEYOR

705 N. MICHIGAN AVE.

HOWELL, MICHIGAN 48843

OFFICE: (517) 546-3340

FAX: 517 546-2941



FEBRUARY 12, 1997

**CORNER SUMMARY**

B-13: SOUTH 1/4 CORNER SECTION 31, T3N-R3E, HANDY TWP. LIV. CO. MI.

GLO SURVEY DATED APRIL 15, 1825 BY S SIBLEY AND NONE OF HIS GLO WITNESSES REMAIN.

M BULLOCK IN 1900 WITNESSED THIS CORNER TO A POPLAR WHICH IS GONE, HE ALSO NOTED IN 1872 THAT THE GLO COMPUTED JOG OF 205.51 EAST MEASURED 271.26, WE FOUND IRONS AT 294.07 (D HUGHES) AND 374.19 (JC MILLER) EAST.

DURING MORE RECENT TIMES SURVEYORS HAVE NOT USED THIS CORNER IN AREA SURVEYS, RATHER WORKED ON A STRAIGHT LINE BETWEEN THE SW AND SE SEC. CORNERS. IN 1996 D HUGHES HAD TWO SURVEYS, ONE IN HANDY TWP. AND THE SECOND IN IOSCO TWP. AND DURING THE PROCESS OF THESE SURVEYS, ESTABLISHED THE SOUTH 1/4 CORNER ON LINE WITH THE SECTION CORNERS AND AT A GLO PRORATED DISTANCE OF 1466.80 TO THE WEST (GLO = 1454.83) AND EAST 2662.08 (GLO = 2640.00). WE FOUND HIS 1/4 CORNER (PK AND WASHER) ON LINE WITH THE SECTION CORNERS AND MEASURED WEST 1466.83 AND EAST 2662.08, HIS WITNESSES ALL CHECKED. PREVIOUS FRACTIONAL MILE MEASURES WERE, 4126.60 BY MUNSELL '60, 4127.41 BY BOSS '73, 4128.88 BY HUGHES '96 AND WE HAD 4128.91 '97. FOUND NO OCCUPATION TO THE NORTH AND DEEDS ARE SUCH THAT THERE WOULD BE NONE. THE CORNER IS LOCATED IN THE EAST BOUND LANE OF AN ASPHALT ROAD AND THE SITE IS QUESTIONABLE FOR GPS WITH TREES TO THE SOUTH, EAST AND WEST. WE RECOMMEND THE CORNER AS ESTABLISHED BY D HUGHES.

CHARLES E. GARLOCK,  
PS 14762  
HAN97B13

**SUCCESSOR TO:**

- MILES W. BULLOCK, L.S. (1844 TO 1926) ● GRANT H DUNNING, P.E. (1885 TO 1928)
- CLAY W. GORDON, RLS (1883 TO 1970) ● LYLE W. MUNSELL, RLS (1904 TO 1987)

FILED