

# SURVEY & REMONUMENTATION

FEB 24 1998

SECTION

LAND CORNER RECORDATION CERTIFICATE  
Filing Requirement of Act 74, Mich. P.A. 1970

FILED

For corners in

LIVINGSTON

Located In:

Corner Code #

(County)

- |                                    |              |              |              |
|------------------------------------|--------------|--------------|--------------|
| 1. Public Land Survey              | T <u>3</u> N | R <u>3</u> E | <u>D-13</u>  |
|                                    | T <u>   </u> | R <u>   </u> | <u>   </u>   |
|                                    | T <u>   </u> | R <u>   </u> | <u>   </u>   |
|                                    | T <u>   </u> | R <u>   </u> | <u>   </u>   |
| 2. Property Controlling in Section | S <u>   </u> | T <u>   </u> | R <u>   </u> |
|                                    | S <u>   </u> | T <u>   </u> | R <u>   </u> |
| 3. Miscellaneous Property in Sec.  | S <u>   </u> | T <u>   </u> | R <u>   </u> |
|                                    | S <u>   </u> | T <u>   </u> | R <u>   </u> |

1997 AUG 27 P 12:32

NANCY HAVILAND  
REGISTER OF DEEDS  
LIVINGSTON COUNTY, MI.  
48843

L.S.C. #692m

Register of Deeds Stamp & File Number

4. Lot No. \_\_\_\_\_, Recorded Plat \_\_\_\_\_  
5. Private Claims \_\_\_\_\_

I, CHARLES E. GARLOCK, in a field survey on AUG. 8, 1997 do hereby state that under requirements of P.A. 74, Michigan P.A. of 1970, the corner points mentioned in lines 1 and 2 above were in conformance with regulations and rules therefore as required in the current manual of survey instructions of the United States Department of the Interior, Bureau of Land Management or by a decree of a Court of Law and/or that the corner points mentioned in lines 3, 4 and 5 above were in conformance with the rules of the Michigan Board of Land Surveyors or by a Decree of a Court of Law; established, re-established, monumented, recovered, found as expressed below:

NOTE: Not more than 2 corners, all in the same town and range, may be recorded on this certificate.

	A	B	C	D	E	F	G	H	I	J	K	L	M
1													
2	6		5		4			3		2		1	
3													
4	7		8		9			10		11		12	
5													
6	18		17		16			15		14		13	
7													
8	19		20		21			22		23		24	
9													
10	30		29		28			27		26		25	
11													
12	31		32		33			34		35		36	
13													

A. Description of original monument and accessories and/or subsequent restoration:

GLO SURVEY DATED APRIL 15, 1825 BY S SIBLEY AND NONE OF THE GLO WITNESSES REMAIN  
GLO WITNESSES: B ASH 12-N27 1/2W-81 LKS  
W ASH 6-N67E-17 LKS

ADDITIONAL HISTORICAL DATA ON REAR OF SHEET

B. Description of corner evidence found and/or method applied in restoring or reestablishing corner:

FOUND 1/2" I. ROD IN ASPHALT ON C/L OF ROAD.

C. Description of monument for corner and accessories established to perpetuate locating the position of the corner:

D-13: S1/4 COR. SEC. 32, T3N-R3E, HANDY TWP. LIV. CO. MI, RESET ABOVE WITH 1 1/4" X 36" BREAKAWAY I. PIPE WITH LIV. CO. REMON BRASS CAP ON TOP AT -0.5' AND IN SET MON. BOX.  
S23W-26.40'-SP & TAG W/S 24" WALNUT  
N53W-61.23'-SP & TAG S/S TRIPLE 10" HICKORY  
N11W-37.70'-SP 7 TAG W/S DBL 30" HICKORY  
N10E-61.86'-SP & TAG E/S 24" WALNUT  
ON C/L OF MASON ROAD.


Signed by

*Charles E. Garlock*

Surveyor's Michigan License No. 14762

Date

AUGUST 23, 1997

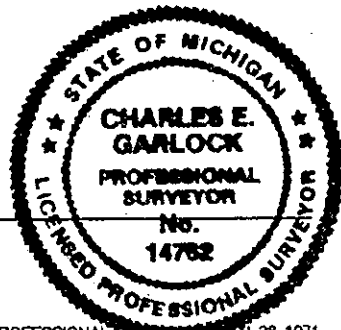

**CHARLES E. GARLOCK**

PROFESSIONAL SURVEYOR

705 N. MICHIGAN AVE.

HOWELL, MICHIGAN 48843

OFFICE: (517) 546-3340

FAX: 517 546-2941



FEBRUARY 12, 1997

**CORNER SUMMARY**

D-13: SOUTH 1/4 COR. SEC. 32, T3N-R3E, HANDY TPW. LIV. CO. MI

GLO SURVEY DATED APRIL 15, 1825 BY S SIBLEY AND NONE OF THE GLO WITNESSES REMAIN.

M BULLOCK IN 1900 WITNESSED A 12" BUTTERNUT N29 3/4W 29.7', WE FOUND A 4 FOOT HIGH STUMP ABOUT 10" DIA. AT N20W 30.7'???? AT THE CORNER WE FOUND A 1/2" I. ROD NEAR THE CENTERLINE OF AN ASPHALT ROAD WITH AN OLD FENCE LINE TO THE NORTH. ALL WITNESSES BY MUNSELL '60, BOSS '77, GARLOCK '81 AND '92 CHECK. GLO JOG COMPUTES EAST 262.02 AND BENTON HAD EAST 335.25, GARLOCK HAD EAST 335.55 AND WE MEASURED EAST 335.21. MEASURES WEST ARE: 2636.40-MUNSELL '60, 2636.02-NEWTON '72, 2632.81-GARLOCK '92, 2635.38-GARLOCK '96 AND WE MEASURED 2635.36 '97. MEASURES EAST ARE: 2632.60-MUNSELL '60, 2632.74-BOSS '77, 2632.63-BOSS '82, 2632.63-BENTON '82, 2633.04-GARLOCK '92 AND WE HAD 2632.72 IN '97. GPS IS MARGINAL TO POOR. WE RECOMMEND CONTINUED USE OF THE CORNER AS FOUND.

CHARLES E GARLOCK  
PS 14762  
HAN97D13

3/3E D13  
4

SUCCESSOR TO:

- MILES W. BULLOCK, L.S. (1844 TO 1926) ● GRANT H DUNNING, P.E. (1865 TO 1926)
- CLAY W. GORDON, RLS (1883 TO 1970) ● LYLE W. MUNSELL, RLS (1904 TO 1997)