

FEB 24 1998

SECTION

LAND CORNER RECORDATION CERTIFICATE
Filing Requirement of Act 74, Mich. P.A. 1970

FILED

For corners in

LIVINGSTON
(County)

Located In:

Corner Code #

1997 AUG 27 P 12: 32

NANCY HAVILAND
REGISTER OF DEEDS
LIVINGSTON COUNTY, MI.
48843

L.S.C. #693m

Register of Deeds Stamp & File Number

- 1. Public Land Survey T 3N R 3E E-13
T _____ R _____
T _____ R _____
T _____ R _____
- 2. Property Controlling S _____ T _____ R _____
in Section S _____ T _____ R _____
- 3. Miscellaneous S _____ T _____ R _____
Property in Sec. S _____ T _____ R _____

- 4. Lot No. _____, Recorded Plat _____
- 5. Private Claims _____

	A	B	C	D	E	F	G	H	I	J	K	L	M
2	6		5		4		3		2		1		
3													
4	7		8		9		10		11		12		
5													
6	13		17		16		15		14		13		
7													
8	19		20		21		22		23		24		
9													
10	30		29		28		27		26		25		
11													
12	31		32		33		34		35		36		
13													

I, CHARLES E. GARLOCK, in a field survey on AUGUST 8, 1997, do hereby certify that under requirements of P.A. 74, Michigan P.A. of 1970, the corner points mentioned in lines 1 and 2 above were in conformance with regulations and rules therefore as required in the current manual of survey instructions of the United States Department of the Interior, Bureau of Land Management or by a decree of a Court of Law and/or that the corner points mentioned in lines 3, 4 and 5 above were in conformance with the rules of the Michigan Board of Land Surveyors or by a Decree of a Court of Law; established, re-established, monumented, re-monumented, recovered, found as expressed below:

NOTE: Not more than 4 corners, all in the same town and range, may be recorded on this certificate.


A. Description of original monument and accessories and/or subsequent restoration:
GLO SURVEY DATED APRIL 15, 1825 BY S SIBLEY AND NONE OF THE GLO WITNESSES REMAIN
GLO WITNESSES: FOUND 8" HICKORY FOR POST

ADDITIONAL HISTORICAL DATA ON REAR OF SHEET

B. Description of corner evidence found and/or method applied in restoring or reestablishing corner:
FOUND A NAIL IN ASPHALT PATCH AND FOUND AN I. ROD BELOW THE SPIKE.

P.A. 345 1980, APPROVED BY LIVINGSTON COUNTY
PEER GROUP ON 2/26/97 CO. REP JED

C. Description of monument for corner and accessories established to perpetuate locating the position of the corner:
E-13: SE COR. SEC. 32, T3N-R3E, HANDY TWP. LIV. CO. MI., RESET ABOVE WITH 1 1/4" X 36" BREAKAWAY I. PIPE WITH LIV. CO. REMON BRASS CAP ON TOP AT -0.5' AND IN SET MON. BOX.
N54W-94.60'-SP 7 TAG S/S 5" ELM
S66W-49.30'-SP 7 TAG N/S 18" HICKORY
S18W-41.07'-SP 7 TAG E/S 16" HICKORY
S34E-32.86'-SP & TAG W/S 18" MAPLE
N44W-51.42'-C/L ST. SIGN POST.
ON C/L ROADS E, W AND N

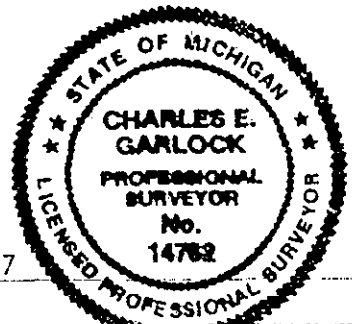

Signed by Charles E. Garlock Date AUGUST 23, 1997
Surveyor's Michigan License No. 14762

"Be Sure of Your Ground"

CHARLES E. GARLOCK

PROFESSIONAL SURVEYOR

705 N. MICHIGAN AVE.

HOWELL, MICHIGAN 48843

OFFICE: (517) 548-3340

FAX: 517 548-2941

FEBRUARY 12, 1997

CORNER SUMMARY

E-13: SE COR. SEC. 32 T3N-R3E, HANDY TWP. LIV. CO. MI

GLO SURVEY DATED APRIL 15, 1825 BY S SIBLEY AND NONE OF THE GLO WITNESSES REMAIN.

M BULLOCKS 1885 WITNESS IS GONE.

IN 1961 MUNSELL SET A 1/2" I. ROD FOR THE CORNER AND HIS REMAINING WITNESSES CHECK AS DO THOSE OF BOSS '77, GARLOCK '81 & '92, DESINE '93 AND HUGHES '95. WE FOUND A NAIL IN AN ASPHALT PATCH AT THE INTERSECTION OF MASON AND NICHOLSON ROADS. GLO JOG IS EAST 252.78 BUT MEASURES 300.30 BOTH '63 AND '97. MEASURES WEST ARE: 2632.60-MUNSELL '61, 2632.74-BOSS '77, 2632.63 BOSS & BENTON '82, 2633.04-GARLOCK '92 AND WE HAD 2632.72 '97. MEASURES EAST ARE: 2614.26-OLD SURVEY RECORDS, 2616.95-DESINE '93, 2616.96-HUGHES '95 AND WE HAD 2616.97 IN '97. GPS SITE IS FAIR TO MARGINAL. WE RECOMMEND CONTINUED USE OF THE CORNER AS FOUND.



CHARLES E GARLOCK

PS 14762

HAN97E13

SUCCESSOR TO:

MILES W. BULLOCK, L.S. (1844 TO 1926)

GRANT H DUNNING, P.E. (1865 TO 1928)

CLAY W. GORDON, RLS (1883 TO 1970)

LYLE W. MUNSELL, RLS (1904 TO 1987)

3/3 E E-13 4