

SURVEY & REMONUMENTATION

FEB 24 1998

SECTION

LAND CORNER RECORDATION CERTIFICATE
Filing Requirement of Act 74, Mich. P.A. 1970

FILED

For corners in

LIVINGSTON
(County)

Located In:

Corner Code #

9

- | | | |
|------------------------------------|-------------------------|-------------|
| 1. Public Land Survey | T <u>3N</u> R <u>3E</u> | <u>F-13</u> |
| | T___ R___ | _____ |
| | T___ R___ | _____ |
| | T___ R___ | _____ |
| 2. Property Controlling in Section | S___ T___ R___ | _____ |
| | S___ T___ R___ | _____ |
| 3. Miscellaneous Property in Sec. | S___ T___ R___ | _____ |
| | S___ T___ R___ | _____ |

1997 AUG 27 P 12: 32

NANCY HAVILAND
REGISTER OF DEEDS
LIVINGSTON COUNTY, MI.
48843

L.S.C. #694m

Register of Deeds Stamp & File Number

4. Lot No. _____, Recorded Plat _____
5. Private Claims _____

I, CHARLES E. GARLOCK, in a field survey on AUG. 8, 1997 do hereby state that under requirements of P.A. 74, Michigan P.A. of 1970, the corner points mentioned in lines 1 and 2 above were in conformance with regulations and rules therefore as required in the current manual of survey instructions of the United States Department of the Interior, Bureau of Land Management or by a decree of a Court of Law and/or that the corner points mentioned in lines 3, 4 and 5 above were in conformance with the rules of the Michigan Board of Land Surveyors or by a Decree of a Court of Law; established, re-established, monumented, recovered, found as expressed below:

NOTE: Not more than 2 corners, all in the same town and range, may be recorded on this certificate.

| | | | | | | | | | | | | | |
|----|----|---|----|---|----|---|----|---|----|---|----|---|---|
| 1 | A | B | C | D | E | F | G | H | I | J | K | L | M |
| 2 | 6 | | 5 | | 4 | | 3 | | 2 | | 1 | | |
| 3 | | | | | | | | | | | | | |
| 4 | 7 | | 8 | | 9 | | 10 | | 11 | | 12 | | |
| 5 | | | | | | | | | | | | | |
| 6 | 10 | | 17 | | 16 | | 15 | | 14 | | 13 | | |
| 7 | | | | | | | | | | | | | |
| 8 | 19 | | 20 | | 21 | | 22 | | 23 | | 24 | | |
| 9 | | | | | | | | | | | | | |
| 10 | 30 | | 29 | | 28 | | 27 | | 26 | | 25 | | |
| 11 | | | | | | | | | | | | | |
| 12 | 31 | | 32 | | 33 | | 34 | | 35 | | 36 | | |
| 13 | | | | | | | | | | | | | |

- A. Description of original monument and accessories and/or subsequent restoration:
GLO SURVEY DATED APRIL 15, 1825 BY S SIBLEY AND NONE OF THE GLO WITNESSES REMAIN.
GLO WITNESSES: SYM 8-N25W-91 LKS
B ASH-9-N23E-16 LKS


ADDITIONAL HISTORICAL DATA ON REAR OF SHEET

- B. Description of corner evidence found and/or method applied in restoring or reestablishing corner:
FOUND A 3/4" X 12" I. PIPE SET ON LINE WITH THE SECTION CORNERS BY DESINE INC. IN 1993 AND AT 1/2 DISTANCE.

- C. Description of monument for corner and accessories established to perpetuate locating the position of the corner:
F-13: S 1/4 COR. SEC. 33, T3N-R3E, HANDY TWP, LIV. CO. MI., RESET ABOVE WITH 1 1/4" X 36" BREAKAWAY I. PIPE WITH LIV. CO. REMON BRASS CAP ON TOP IN A SET MON. BOX! AT -0.5'
S38W-43.28'-SP & TAG E/S 18" ASH
S18W-48.94'-SP & TAG W/S 16" OAK
S25E-70.85'-SP & TAG E/S 14' MAPLE
S45E-67.72'-SP & TAG W/S 30" OAK
SOUTH-2.5'-C/L MASON ROAD.

Signed by Charles E. Garlock
Surveyor's Michigan License No. 14762

Date AUGUST 23, 1997

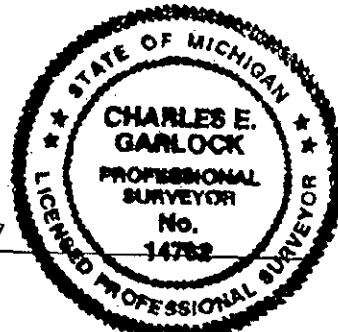

"Be Sure of Your Ground"

CHARLES E. GARLOCK

PROFESSIONAL SURVEYOR

705 N. MICHIGAN AVE.

HOWELL, MICHIGAN 48843

OFFICE: (517) 546-9340

FAX: 517 546-2941

FEBRUARY 12, 1997

CORNER SUMMARY

F-13: SOUTH 1/4 COR. SEC. 33, T3N-R3E, HANDY TWP. LIV. CO. MI.

GLO SURVEY DATED APRIL 15, 1825 BY S SIBLEY AND NONE OF THE GLO WITNESSES REMAIN.

FOUND NO EARLY WITNESSES TO THIS CORNER, BUT FOUND OLD SURVEY NOTES WITH THE DISTANCE EAST AND WEST OF 2614.26. IN 1993 DESINE SET A 3/4" I. PIPE ON LINE WITH THE SW AND SE SECTION CORNERS AT HALF DISTANCE. THEIR WITNESSES CHECKED AS DID THOSE OF D HUGHES IN '95. WE FOUND A 3/4" I. PIPE WITH NO CAP 2.5 FEET NORTH OF THE CENTERLINE OF MASON ROAD UNDER COLD PATCH AND WITH NO OCCUPATION TO THE NORTH BECAUSE BOTH QUARTERS ARE OWNED BY THE SAME PERSON. THE COMPUTED GLO JOG IS EAST 208.89 FEET AND IT MEASURES 304.42 FEET. MEASURES WEST ARE: 2616.95-DESINE '93, 2616.96-HUGHES '95 AND WE HAD 2616.97 IN '97. MEASURES EAST ARE: 2616.95-DESINE '93, 2616.87-HUGHES '95 AND WE HAD 2616.88 IN '97. MUNSELL MEASURED THE MILE AT 5233.30 IN '60 WHICH IS 2616.65 FOR HALF DISTANCE. SITE HAS HIGH HARD WOODS TO THE SOUTH AND OPEN ON THE NORTH SIDE OF THE ASPHALT ROAD, GPS STATION WOULD BE FAIR.

RECOMMEND CONTINUED USE OF THE CORNER AS SET BY DESINE.

Charles E. Garlock

CHARLES E GARLOCK

PS 14762

HAN97F131

SUCCESSOR TO:

MILES W. BULLOCK, L.S. (1844 TO 1928)

GRANT H DUNNING, P.E. (1885 TO 1928)

CLAY W. GORDON, RLS (1883 TO 1970)

LYLE W. MUNSELL, RLS (1904 TO 1987)

2002
F-13
4