

SURVEY & RECOMMENDATION

MAR 17 2000

FILED

SECTION

LAND CORNER RECORDATION CERTIFICATE
Filing Requirement of Act 74, Mich. P.A. 1970

1999 MAY 21 A 9:21

For corners in

LIVINGSTON
(County)

Located In:

Corner Code #

1. Public Land Survey

T3N R3E G4

2. Property Controlling in Section

S _____ T _____ R _____

3. Miscellaneous Property in Sec.

S _____ T _____ R _____

NANCY HAVILAND
REGISTER OF DEEDS
LIVINGSTON COUNTY, MI.
48843

L.S.C.#993m

Register of Deeds Stamp & File Number

4. Lot No. _____, Recorded Plat _____
5. Private Claims _____

I, CHARLES E GARLOCK, in a field survey on APRIL 28 1999 do hereby state that under requirements of P.A. 74, Michigan P.A. of 1970, the corner points mentioned in lines 1 and 2 above were in conformance with regulations and rules therefore as required in the current manual of survey instructions of the United States Department of the Interior, Bureau of Land Management or by a decree of a Court of Law and/or that the corner points mentioned in lines 3, 4 and 5 above were in conformance with the rules of the Michigan Board of Land Surveyors or by a Decree of a Court of Law; established, re-established, monumented, recovered, found as expressed below:

NOTE: Not more than 2 corners, all in the same town and range, may be recorded on this certificate.

A	B	C	D	E	F	G	H	I	J	K	L	M
1												
2	6		5		4		3		2		1	
3												
4	7		8		9		10		11		12	
5												
6	10		17		16		15		14		13	
7												
8	19		20		21		22		23		24	
9												
10	30		29		28		27		26		25	
11												
12	31		32		33		34		35		36	
13												


A. Description of original monument and accessories and/or subsequent restoration:
GLO SURVEY DATED APRIL 15, 1825 BY S SIBLEY AND NONE OF THE GLO WITNESSES REMAIN.
GLO WITNESSES MAPLE 12 S70E 2.64'
SYM 10 S84W 18.48'

B. Description of corner evidence found and/or method applied in restoring or reestablishing corner:
FOUND 1 1/4" X 24" I. PIPE WITH NIPPLE ON TOP AND CROCKERY AROUND THE BASE

C. Description of monument for corner and accessories established to perpetuate locating the position of the corner:
G4: W 1/4 COR. SEC. 10, T3N-R3E, HANDY TWP. LIV. CO. MI. REPLACED FOUND IRON WITH 1 1/4" X 36 BREAKAWAY I. PIPE WITH LIV. CO. REMON CAP #14762
S45W-21.56'-SP & TAG E/S U POLE
S88E-27.61'-SP & TAG N/S 10" MAPLE
S82E-41.17'-SP & TAG N/S 12" CEDAR
S10W-125.86'-SP 7 TAG E/S 48" OAK
EAST-5.0'-C/L OF ROAD.

Signed by Charles E. Garlock
Surveyor's Michigan License No. 14762

Date MAY 1, 1999

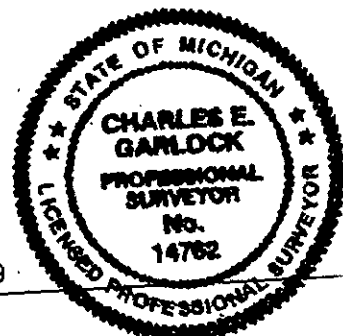

P.A. 345 1990, APPROVED BY LIVINGSTON COUNTY
PEER GROUP ON 3-17-99 CO. REP JED