

MAR 17 2000

FILED

SECTION

LAND CORNER RECORDATION CERTIFICATE  
Filing Requirement of Act 74, Mich. P.A. 1970

For corners in

LIVINGSTON  
(County)

Located In:

Corner Code #

- 1. Public Land Survey      T3N R 3E      G5  
   T    R  
   T    R  
   T    R
- 2. Property Controlling    S    T    R  
   in Section                S    T    R
- 3. Miscellaneous            S    T    R  
   Property in Sec.         S    T    R

1999 MAY 21 A 9:21

NANCY HAVILAND  
REGISTER OF DEEDS  
LIVINGSTON COUNTY, MI.  
48843

L.S.C. #992

Register of Deeds Stamp & File Number

- 4. Lot No. \_\_\_\_\_, Recorded Plat \_\_\_\_\_
- 5. Private Claims \_\_\_\_\_

I, CHARLES E GARLOCK, in a field survey on APRIL 5, 1999 do hereby state that under requirements of P.A. 74, Michigan P.A. of 1970, the corner points mentioned in lines 1 and 2 above were in conformance with regulations and rules therefore as required in the current manual of survey instructions of the United States Department of the Interior, Bureau of Land Management or by a decree of a Court of Law and /or that the corner points mentioned in lines 3, 4 and 5 above were in conformance with the rules of the Michigan Board of Land Surveyors or by a Decree of a Court of Law; established, re-established, monumented, recovered, found as expressed below:

NOTE: Not more than 2 corners, all in the same town and range, may be recorded on this certificate.


A	B	C	D	E	F	G	H	I	J	K	L	M
1												
2	6	5	4	3	2	1						
3												
4	7	8	9	10	11	12						
5												
6	18	17	16	15	14	13						
7												
8	19	20	21	22	23	24						
9												
10	30	29	28	27	26	25						
11												
12	31	32	33	34	35	36						
13												

A. Description of original monument and accessories and/or subsequent restoration:

GLO SURVEY DATED: APRIL 15, 1825 BY S SIBLEY AND NONE OF THE GLO WITNESSES REMAIN.  
GLO WITNESSES: SUGAR 10-S54W-16.50'  
IRONWOOD 6-N77E-17.82'

B. Description of corner evidence found and/or method applied in restoring or reestablishing corner:

FOUND 1/2" I. ROD 1.5' SOUTH OF NORTH RAIL OF EAST-WEST RAILROAD AND ON C/L OF GREGORY RD. TO THE NORTH & SOUTH..

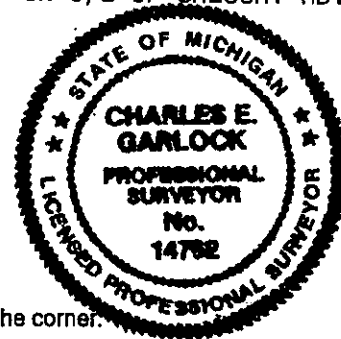

C. Description of monument for corner and accessories established to perpetuate locating the position of the corner:

G5: SW COR. SEC. 10 T3N-R3E HANDY TWP. LIV. CO. AND LEFT THE FOUND 1/2" I. ROD IN PLACE  
N29W-80.87'-SP & TAG E/S U. POLE  
N67E-58.34'-SP & TAG W/S T. POLE  
S18E-55.43'-SP & TAG W/S U. POLE  
S68W-74.25'-SP & TAG W/S 7" ELM  
N60\*01'24"E-53.49'-1" X 36" I. PIPE WITH LIV. CO. REMON WITNESS CAP ON TOP  
S60\*01'24"W-53.49'-1" X 36" I. PIPE WITH LIV. CO. REMON WITNESS CAP ON TOP  
NORTH-1.6'- C/L OF THE NORTH RAIL.

Signed by Charles E. Garlock  
Surveyor's Michigan License No. 14762

Date APRIL 7, 1999