

FEB 24 1998

SECTION

LAND CORNER RECORDATION CERTIFICATE
Filing Requirement of Act 74, Mich. P.A. 1970

FILED

For corners in

LIVINGSTON
(County)

Located In:

Corner Code # 9-

1997 AUG 27 P 12:32

NANCY HAVILAND
REGISTER OF DEEDS
LIVINGSTON COUNTY, MI.
48843

- 1. Public Land Survey T3N R3E G-13
 T R
 T R
 T R
- 2. Property Controlling S T
 in Section S T
- 3. Miscellaneous S T
 Property in Sec. S T

L.S.C. #695m

Register of Deeds Stamp & File Number.

- 4. Lot No. _____, Recorded Plat _____
- 5. Private Claims _____

I, CHARLES E. GARLOCK, in a field survey on AUG 8, 1997 do hereby state that under requirements of P.A. 74, Michigan P.A. of 1970, the corner points mentioned in lines 1 and 2 above were in conformance with regulations and rules therefore as required in the current manual of survey instructions of the United States Department of the Interior, Bureau of Land Management or by a decree of a Court of Law and /or that the corner points mentioned in lines 3, 4 and 5 above were in conformance with the rules of the Michigan Board of Land Surveyors or by a Decree of a Court of Law; established, re-established, monumented, recovered, found as expressed below:

NOTE: Not more than 2 corners, all in the same town and range, may be recorded on this certificate.

1	A	B	C	D	E	F	G	H	I	J	K	L	M
2	6		5		4		3		2		1		
3													
4	7		8		9		10		11		12		
5													
6	18		17		16		15		14		13		
7													
8	19		20		21		22		23		24		
9													
10	30		29		28		27		26		25		
11													
12	31		32		33		34		35		36		
13													

A. Description of original monument and accessories and/or subsequent restoration:
GLO SURVEY DATED BY S SIBLEY APRIL 15, 1825 AND NONE OF THE GLO WITNESSES REMAIN.
GLO WITNESSES: BO 30-N30W-23 LKS
RO 13-N72E-22 LKS


ADDITIONAL HISTORICAL DATA ON REAR OF SHEET

B. Description of corner evidence found and/or method applied in restoring or reestablishing corner:
FOUND 1/2" I. ROD ON C/L'S OF MASON ROAD E-W AND GREGORY ROAD TO THE N.

C. Description of monument for corner and accessories established to perpetuate locating the position of the corner:
G-13: SE COR. SEC. 33 T3N-R3E, HANDY TWP. LIV. CO. MI., RESET ABOVE WITH 1 1/4" X 36" BREAKAWAY I. PIPE WITH LIV. CO. REMON BRASS CAP ON TOP AT -0.5' IN SET MON. BOX N39W-53.23'-SP & TAG W/S DBL 8" ELM N68E-104.13'-SW COR. STEEL QUONSET BLDG. N25E-123.80'-C/L 3" PINE S15W-20.04'-C/L E. LEG OF ARROW & ST. SIGN POST

Signed by Charles E. Garlock
Surveyor's Michigan License No. 14762

Date AUGUST 23, 1997

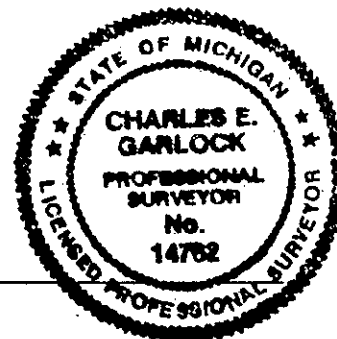


CHARLES E. GARLOCK

PROFESSIONAL SURVEYOR

705 N. MICHIGAN AVE.
HOWELL, MICHIGAN 48843

OFFICE: (517) 546-3340

FAX: 517 546-2941

 

FEBRUARY 12, 1997

CORNER SUMMARY

G-13: SE COR. SEC. 33 T3N-R3E, HANDY TWP. LIV. CO. MI

GLO SURVEY DATED APRIL 15, 1825 BY S SIBLEY AND NONE OF THE GLO WITNESSES REMAIN.

BULLOCKS 1898 WITNESS IS GONE.

DURING THE MASON ROAD RECONSTRUCTION AND SURVEY, MUNSELL IN 1961 SET A 1/2" I. ROD FOR THIS CORNER THAT WAS LATER RESET BY NEWTON IN '72; REMAINING WITNESSES BY MUNSELL-'61, NEWTON-'72, BOSS-'75, GARLOCK-'81, HUGHES-'89, DESINE-'93 AND HUGHES AGAIN IN '95 CHECK AND ALL STATE IT IS A 1/2" I. ROD. WE FOUND A 1/2" I. ROD AT THE CENTERLINE ROAD INTERSECTION OF MASON AND GREGORY (TO THE NORTH) ROADS NEAR THE ASPHALT SURFACE. THE GLO JOG EAST IS 297.00 WHICH I SET AT 297.00 EAST IN '83 AND IT FELL ON THE EXISTING CENTERLINE OF GREGORY ROAD TO THE SOUTH. IT PRESENTLY MEASURES 296.96 FEET, BUT BULLOCK HAD LISTED THE JOG AS 169.22 FEET EAST (???). MEASURES WEST ARE: 2614.26 FROM OLD SURVEY NOTES, 2616.95 BY DESINE '93, 2616.87 BY HUGHES '95 AND WE HAD 2616.88 IN '97. MEASURES EAST ARE: 2659.80 FROM OLD SURVEY NOTES, 2647.69 BY NEWTON '72, 2647.95 BY GARLOCK '83, 2647.81 BY HUGHES '89 AND WE HAD 2647.89 IN '97. SITE IS GOOD FOR GPS. RECOMMEND CONTINUED USE OF THE CORNER AS FOUND.

CHARLES E GARLOCK
PS 14762
HAN97G13

3N3E

G-13

4

SUCCESSOR TO:

- MILES W. BULLOCK, L.S. (1844 TO 1926) ● GRANT H DUNNING, P.E. (1865 TO 1928)
- CLAY W. GORDON, RLS (1883 TO 1970) ● LYLE W. MUNSELL, RLS (1904 TO 1987)