

MAR 17 2000

FILED

SECTION

LAND CORNER RECORDATION CERTIFICATE
Filing Requirement of Act 74, Mich. P.A. 1970

For corners in

LIVINGSTON
(County)

Located In: Corner Code #

- 1. Public Land Survey
] T3N R3E H5
T___R___
T___R___
T___R___
- 2. Property Controlling
in Section S___T___R___
S___T___R___
- 3. Miscellaneous
Property in Sec. S___T___R___
S___T___R___

1999 MAY 21 A 9:21

NANCY HAVILAND
REGISTER OF DEEDS
LIVINGSTON COUNTY, MI.
48843

L.S.C.#997m

Register of Deeds Stamp & File Number

- 4. Lot No. _____, Recorded Plat _____
- 5. Private Claims _____

I, CHARLES E GARLOCK, in a field survey on APRIL 5 1999 do hereby state that under requirements of P.A. 74, Michigan P.A. of 1970, the corner points mentioned in lines 1 and 2 above were in conformance with regulations and rules therefore as required in the current manual of survey instructions of the United States Department of the Interior, Bureau of Land Management or by a decree of a Court of Law and /or that the corner points mentioned in lines 3, 4 and 5 above were in conformance with the rules of the Michigan Board of Land Surveyors or by a Decree of a Court of Law; established, re-established, monumented, recovered, found as expressed below:

NOTE: Not more than 2 corners, all in the same town and range, may be recorded on this certificate.


	A	B	C	D	E	F	G	H	I	J	K	L	M
1													
2	6		5		4		3		2		1		
3													
4	7		8		9		10		11		12		
5													
6	18		17		16		15		14		13		
7													
8	19		20		21		22		23		24		
9													
10	30		29		28		27		26		25		
11													
12	31		32		33		34		35		36		
13													

A. Description of original monument and accessories and/or subsequent restoration:

GLO SURVEY DATED: APRIL 15, 1825 BY S SIBLEY AND NONE OF THE GLO WITNESSES REMAIN
GLO WITNESSES: ELM 8-N581/2E-13.20'
BUTTERNUT 10-S88W-12.54'

B. Description of corner evidence found and/or method applied in restoring or reestablishing corner:

FOUND PK SPIKE IN CENTERLINE OF EAST-WEST RAILROAD AND INLINE WITH FENCE LINE TO THE NORTH.

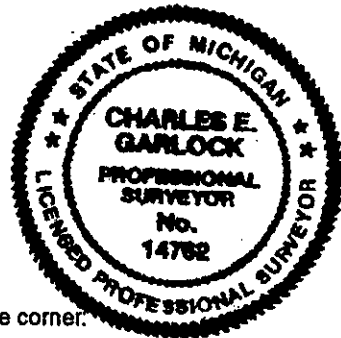

C. Description of monument for corner and accessories established to perpetuate locating the position of the corner:

H5: S 1/4 COR. SEC. 10 T3N-R3E, HANDY TWP. LIV. CO. MI, LEFT THE FOUND PK SPIKE IN PLACE ON THE WEST EDGE OF A RAILROAD TIE.
N38E-16.62'-NW COR. RR COMMUNICATION BOX 3.32' X 1.55' X 5.30'
N35*05'23"E-40.23'-1" X 36" I. PIPE W/LIV. CO. REMON WITNESS CAP ON TOP
S35*05'23"W-40.23'-1" X 36" I. PIPE W/LIV. CO. REMON WITNESS CAP ON TOP
S64W-117.80'-SP & TAG N/S U. POLE
N67W-96.73'-SP & TAG S/S T. POLE
NORTH & SOUTH-2.50'-C/L OF THE TWO RAILS.

Signed by Charles E. Garlock
Surveyor's Michigan License No. 14762

Date APRIL 7, 1999