

SURVEY & REMONUMENTATION

FEB 24 1998

LAND CORNER RECORDATION CERTIFICATE
Filing Requirement of Act 74, Mich. P.A. 1970

FILED

For corners in

<u>LIVINGSTON</u> (County)	Located In:	Corner Code #	91
1. Public Land Survey	T <u>3N</u> R <u>3E</u>	H-13	
	T _____ R _____	_____	
	T _____ R _____	_____	
	T _____ R _____	_____	
2. Property Controlling in Section	S _____ T _____ R _____	_____	
	S _____ T _____ R _____	_____	
3. Miscellaneous Property in Sec.	S _____ T _____ R _____	_____	
	S _____ T _____ R _____	_____	

1997 AUG 27 P 12:33

NANCY HAVILAND
REGISTER OF DEEDS
LIVINGSTON COUNTY, MI.
48843

L.S.C. #696m

Register of Deeds Stamp & File Number

4. Lot No. _____, Recorded Plat _____
5. Private Claims _____

I, CHARLES E GARLOCK, in a field survey on AUG 8, 1997 do hereby state that under requirements of P.A. 74, Michigan P.A. of 1970, the corner points mentioned in lines 1 and 2 above were in conformance with regulations and rules therefore as required in the current manual of survey instructions of the United States Department of the Interior, Bureau of Land Management or by a decree of a Court of Law and for that the corner points mentioned in lines 3, 4 and 5 above were in conformance with the rules of the Michigan Board of Land Surveyors or by a Decree of a Court of Law; established, re-established, monumented, recovered, found as expressed below:

1	A	B	C	D	E	F	G	H	I	J	K	L	M
2		6		5		4		3		2		1	
3													
4		7		8		9		10		11		12	
5													
6		18		17		16		15		14		13	
7													
8		19		20		21		22		23		24	
9													
10		30		29		28		27		26		25	
11													
12		31		32		33		34		35		36	
13													

NOTE: Not more than 2 corners, all in the same town and range, may be recorded on this certificate.

A. Description of original monument and accessories and/or subsequent restoration:
GLO SURVEY DATED APRIL 15, 1825 BY S SIBLEY AND NONE OF THE GLO WITNESSES REMAIN
GLO WITNESSES: B ASH 7-N54E-17 LKS
ELM 9-N61W-70 LKS

ADDITIONAL HISTORICAL DATA ON REAR OF SHEET


B. Description of corner evidence found and/or method applied in restoring or reestablishing corner:
FOUND 1/2" I. ROD SET ON LINE WITH THE SECTION CORNERS AT 1/2 DISTANCE, BY W NEWTON IN 1972.

C. Description of monument for corner and accessories established to perpetuate locating the position of the corner:

H-13: S 1/4 COR. SEC. 34 T3N-R3E, HANDY TWP. LIV. CO. MI., RESET ABOVE WITH 1 1/4" X 36" BREAKAWAY I. PIPE WITH LIV. CO. REMON BRASS CAP ON TOP AT -0.5' IN A SET MON. BOX.
S85W-140.03'-SP & TAG N/S 12" MAPLE
S70W-79.99'-SP & TAG N/S 10" ASH
S34W-40.23'-SP & TAG W/S 7" ASH
S70E-150.59'-SP & TAG N/S CTR. TRIPLE 7" ASH
SOUTH-1.5'-C/L MASON ROAD

Signed by Charles E. Garlock
Surveyor's Michigan License No. 14762

Date AUGUST 23, 1997

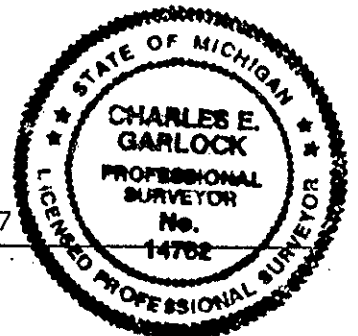

P.A. 345 1990, APPROVED BY LIVINGSTON COUNTY
PEER GROUP ON 2/26/97 CO. REP JED

Be Sure of your Ground

CHARLES E. GARLOCK

PROFESSIONAL SURVEYOR
705 N. MICHIGAN AVE.
HOWELL, MICHIGAN 48843
OFFICE: (517) 546-9340
FAX: 517 546-2941



FEBRUARY 13, 1997

CORNER SUMMARY

H-13: S 1/4 COR. SEC. 34, T3N-R3E, HANDY TWP. LIV. CO. MI

GLO SURVEY DATED APRIL 15, 1825 BY S SIBLEY AND NONE OF THE GLO WITNESSES REMAIN.

M BULLOCKS 1885 WITNESS TREE IS GONE.

IN 1972 NEWTON SET THIS CORNER ON LINE WITH THE SW AND SE SECTION CORNERS AT 1/2 DISTANCE WITH A 1/2" I. ROD. HIS WITNESSES AND THOSE OF BOSS '80, GARLOCK '81, HUGHES '89 AND BOSS '91 CHECK. THE GLO JOG COMPUTES TO BE 142.23 EAST BUT WAS FOUND TO MEASURE 238.95 EAST. PREVIOUS SURVEYORS FOUND IT AT 238.69 AND 238.93.

MEASURES WEST ARE: 2659.80-OLD SURVEY NOTES, 2647.69-NEWTON '72, 2647.95-GARLOCK '83, 2647.81-HUGHES '89 AND WE HAD 2647.89 '97.

MEASURES EAST ARE: 2647.69-NEWTON '72, 2648.12-BOSS '80, 2647.95-GARLOCK '83, 2647.99-HUGHES '89, 2647.93-BOSS '91 AND WE HAD 2647.97 IN '97.

NO OCCUPATION TO THE NORTH
SITE IS GOOD FOR GPS

RECOMMEND CONTINUED USE OF THIS CORNER AS SET BY NEWTON.

CHARLES E GARLOCK
PS 14762
HAN97H13

SUCCESSOR TO:

- MILES W. BULLOCK, L.S. (1844 TO 1926) ● GRANT H DUNNING, P.E. (1865 TO 1928)
- CLAY W. GORDON, RLS (1883 TO 1970) ● LYLE W. MUNSELL, RLS (1904 TO 1987)

3N3E H-13 4