

SURVEY &
REMONUMENTATION

MAR 17 2000

FILED

LAND CORNER RECORDATION CERTIFICATE
Filing Requirement of Act 74, Mich. P.A. 1970

For corners in SECTION

LIVINGSTON (County)	Located In:	Corner Code #
1. Public Land Survey	T3N R3E	I 3
	T R	
	T R	
	T R	
2. Property Controlling in Section	S T R	
	S T R	
3. Miscellaneous Property in Sec.	S T R	
	S T R	

1999 MAY 21 A 9:21

NANCY HAVILAND
REGISTER OF DEEDS
LIVINGSTON COUNTY, MI.
48843

L.S.C. #999m

Register of Deeds Stamp & File Number

4. Lot No. _____, Recorded Plat _____
5. Private Claims _____

I, CHARLES E GARLOCK, in a field survey on APRIL 28, 1999 do hereby state that under requirements of P.A. 74, Michigan P.A. of 1970, the corner points mentioned in lines 1 and 2 above were in conformance with regulations and rules therefore as required in the current manual of survey instructions of the United States Department of the Interior, Bureau of Land Management or by a decree of a Court of Law and/or that the corner points mentioned in lines 3, 4 and 5 above were in conformance with the rules of the Michigan Board of Land Surveyors or by a Decree of a Court of Law; established, re-established, monumented, recovered, found as expressed below:

NOTE: Not more than 2 corners, all in the same town and range, may be recorded on this certificate.

	A	B	C	D	E	F	G	H	I	J	K	L	M
1													
2		6		5		4		3		2		1	
3													
4		7		8		9		10		11		12	
5													
6		18		17		16		15		14		13	
7													
8		19		20		21		22		23		24	
9													
10		30		29		28		27		26		25	
11													
12		31		32		33		34		35		36	
13													

A. Description of original monument and accessories and/or subsequent restoration:

GLO SURVEY DATED APRIL 15, 1825 BY S SIBLEY AND NONE OF THE GLO WITNESSES REMAIN.
GLO WITNESSES SWP W0 26-S47½W-135.96'
ELM 36-N88W-123.09'

B. Description of corner evidence found and/or method applied in restoring or reestablishing corner:


FOUND 1" I. ROD IN MON. BOX, IN LINE WITH OLD FENCE LINE TO WEST, C/L OF SHARPE ROAD EAST AND 2' WEST OF FOWLerville ROAD TO NORTH & SOUTH.

C. Description of monument for corner and accessories established to perpetuate locating the position of the corner:

I 3: NE COR. SEC. 10, T3N-R3E, HANDY TWP. LIV. CO. MI. SET 1¼" X 6" I. PIPE (CEMETED) ON FOUND 1" I. ROD AND LIV. CO. REMON CAP ON TOP #14762
S35E-64.76'-SP & TAG N/S U POLE
N40E-51.68'-SP & TAG S/S U POLE
N30W-39.86'-SP & TAG E/S U POLE
WEST-26.77'-SP & TAG N/S 16" ELM
S35W-45.60'-SP & TAG E/S 15" ELM

Signed by Charles E. Garlock
Surveyor's Michigan License No. 14762

Date MAY 1, 1999

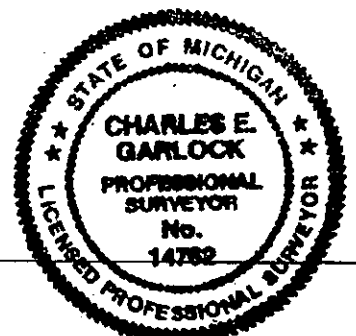

P.A. 345 1990, APPROVED BY LIVINGSTON COUNTY
PEER GROUP ON 3-17-99, CO. REP JEO