

MAR 17 2000

FILED

SECTION

LAND CORNER RECORDATION CERTIFICATE
Filing Requirement of Act 74, Mich. P.A. 1970

For corners in

1999 MAY 21 A 9:21

NANCY HAVILAND
REGISTER OF DEEDS
LIVINGSTON COUNTY, MI.
48843

L.S.C.#1001m

Register of Deeds Stamp & File Number

<u>LIVINGSTON</u> (County)	Located in:	Corner Code #
1. Public Land Survey	T3N R 3E	T 5
	T R	
	T R	
	T R	
2. Property Controlling in Section	S T R	
	S T R	
3. Miscellaneous Property in Sec.	S T R	
	S T R	

4. Lot No. _____, Recorded Plat _____
5. Private Claims _____

I, CHARLES E GARLOCK, in a field survey on APRIL 28, 1999 do hereby state that under requirements of P.A. 74, Michigan P.A. of 1970, the corner points mentioned in lines 1 and 2 above were in conformance with regulations and rules therefore as required in the current manual of survey instructions of the United States Department of the Interior, Bureau of Land Management or by a decree of a Court of Law and /or that the corner points mentioned in lines 3, 4 and 5 above were in conformance with the rules of the Michigan Board of Land Surveyors or by a Decree of a Court of Law; established, re-established, monumented, recovered, found as expressed below:

NOTE: Not more than 2 corners, all in the same town and range, may be recorded on this certificate.

1	A	B	C	D	E	F	G	H	I	J	K	L	M
2		6		5		4		3		2		1	
3													
4		7		8		9		10		11		12	
5									●				
6		18		17		16		15		14		13	
7													
8		19		20		21		22		23		24	
9													
10		30		29		28		27		26		25	
11													
12		31		32		33		34		35		36	
13													

A. Description of original monument and accessories and/or subsequent restoration:

GLO SURVEY DATED APRIL 15, 1825 BY S SIBLEY AND NONE OF THE GLO WITNESSES REMAIN.
GLO WITNESSES: W032-N34E-9.9'
B010-N82W-21.12'

B. Description of corner evidence found and/or method applied in restoring or reestablishing corner:


FOUND 3/4" X 6" I. PIPE C/L OF ASPHALT THAT IS THE BEST FIT OF THE OLD PLATS IN CITY OF FOWLerville AND SET BY JK SMITH #35999

C. Description of monument for corner and accessories established to perpetuate locating the position of the corner:

I5: SE COR. SEC. 10, T3N-R3E, HANDY TWP. LIV. CO MI, REPLACED FOUND IRON WITH MON. BOX AND 1 1/2" X 36" BREAKAWAY I. PIPE WITH LIV. CO. REMON CAP ON TOP #14762
WEST-53.42'-NE COR. HSE FDN #318
N75W-63.77'-SE COR. PORCH FDN #310
N40E-81.12'-NW COR. HSE FDN. #311
S45E-125.12'-NW COR. HSE FDN. #323

Signed by Charles E Garlock
Surveyor's Michigan License No. 14762

Date MAY 1, 1999

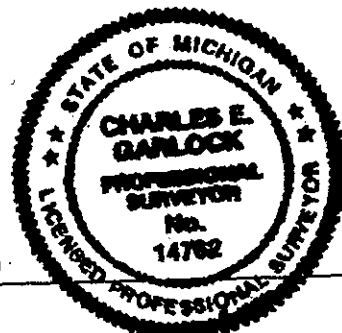

P.A. 345 1990, APPROVED BY LIVINGSTON COUNTY
PEER GROUP ON 2.3.99, CO. REP JED