

SURVEY & RECONSTRUCTION

MAR 17 2000

FILED

LAND CORNER RECORDATION CERTIFICATE  
Filing Requirement of Act 74, Mich. P.A. 1970

SECTION

1999 MAY 21 A 9:21

NANCY HAVILAND  
REGISTER OF DEEDS  
LIVINGSTON COUNTY, MI.  
48843

L.S.C.#1002m

Register of Deeds Stamp & File Number

For corners in

LIVINGSTON  
(County)

Located In:

Corner Code #

1. Public Land Survey

T3N R 3E T 6  
T R  
T R  
T R

2. Property Controlling in Section

S T R  
S T R  
S T R  
S T R

3. Miscellaneous Property in Sec.

4. Lot No. \_\_\_\_\_ Recorded Plat \_\_\_\_\_  
5. Private Claims \_\_\_\_\_

CHARLES E GARLOCK in a field survey on APRIL 28, 1999 do hereby state that under requirements of P.A. 74, Michigan P.A. of 1970, the corner points mentioned in lines 1 and 2 above were in conformance with regulations and rules therefore as required in the current manual of survey instructions of the United States Department of the Interior, Bureau of Land Management or by a decree of a Court of Law and for that the corner points mentioned in lines 3, 4 and 5 above were in conformance with the rules of the Michigan Board of Land Surveyors or by a Decree of a Court of Law, established, re-established, monumented, recovered, found as expressed below:


NOTE: Not more than 2 corners, all in the same town and range, may be recorded on this certificate.

A	B	C	D	E	F	G	H	I	J	K	L	I
1												
2	6		5		4		3		2			
3												
4	7		8		9		10		11		12	
5												
6	18		17		16		15		14		13	
7												
8	19		20		21		22		23		24	
9												
10	30		29		28		27		26		25	
11												
12	31		32		33		34		35		36	
13												

A. Description of original monument and accessories and/or subsequent restoration:  
GLO SURVEY DATED APRIL 15, 1825 BY S SIBLEY AND NONE OF THE GLO WITNESSES REMAIN.  
GLO WITNESSES: IRONWOOD 5-S16E-1.98'  
BEECH 12-N9½E-27.06'

B. Description of corner evidence found and/or method applied in restoring or reestablishing corner:  
FOUND 1/2" I. ROD 1.37' SOUTH OF THE C/L OF THE SOUTH RIM OF A MANHOLE.

C. Description of monument for corner and accessories established to perpetuate locating the position of the corner:  
I6: W 1/4 SEC. 14, T3N-R3E HANDY TWP. LIV. CO. MI. RESET I. ROD WITH 1½" X 36" BREAKAWAY I. PIPE WITH LIV. CO. REMON CAP ON TOP #14762 FLUSH WITH THE ASPHALT. COULD NOT SET IRON IN A MON. BOX, IT WAS TOO CLOSE TO THE MANHOLE BODY.  
S45W-63.72'-SP & TAG N/S U. POLE  
N45W-71.85'-SP & TAG S/S U POLE  
N50E-57.97'-C/L OF S. BOLT OF 10" STEEL POST FOR SIGNAL LIGHT  
S50E-72.85'-SP & TAG N/S U POLE  
COR. ON C/L OF FOWLerville AND VAN RIPER ROADS.

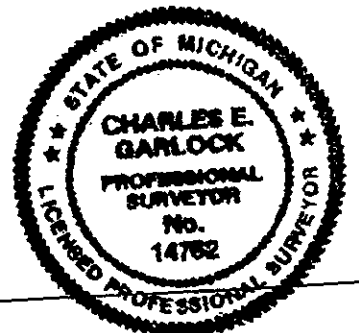

Signed by Charles E. Garlock  
Surveyor's Michigan License No. 14762

Date MAY 1, 1999

PA. 345 1990. APPROVED BY LIVINGSTON COUNTY  
PEER GROUP ON 2.3.99 CO. REP JEO

FORM APPROVED BY MICHIGAN STATE BOARD OF PROFESSIONAL SURVEYORS, JAN. 28, 197  
REVISED MAY 14, 197  
REVISED JAN., 198  
REVISED OCT., 198