

SURVEY & REMONUMENTATION

FEB 25 1999

SECTION LAND CORNER RECORDATION CERTIFICATE
Filing Requirement of Act 74, Mich. P.A. 1970

FILED

For corners in

LIVINGSTON
(County)

Located In:

Corner Code #

1. Public Land Survey

T3N R 3E I8

2. Property Controlling in Section

S T R

3. Miscellaneous Property in Sec.

S T R
S T R

4. Lot No. _____, Recorded Plat _____
5. Private Claims _____


9-
1998 AUG 20 P 4:44
NANCY HAVILAND
REGISTER OF DEEDS
LIVINGSTON COUNTY, MI.
48843
L.S.C. #872m
Register of Deeds Stamp & File Number

I, CHARLES E GARLOCK, in a field survey on AUG 7, 1998 do hereby state that under requirements of P.A. 74, Michigan P.A. of 1970, the corner points mentioned in lines 1 and 2 above were in conformance with regulations and rules therefore as required in the current manual of survey instructions of the United States Department of the Interior, Bureau of Land Management or by a decree of a Court of Law and/or that the corner points mentioned in lines 3, 4 and 5 above were in conformance with the rules of the Michigan Board of Land Surveyors or by a Decree of a Court of Law, established, re-established, monumented, recovered, found as expressed below:

NOTE: Not more than 2 corners, all in the same town and range, may be recorded on this certificate.

	A	B	C	D	E	F	G	H	I	J	K	L	M
1													
2	6		5		4		3		2		1		
3													
4	7		8		9		10		11		12		
5													
6	10		17		16		15		14		13		
7													
8	19		20		21		22		23		24		
9													
10	30		29		28		27		26		25		
11													
12	31		32		33		34		35		36		
13													

A. Description of original monument and accessories and/or subsequent restoration:
GLO SURVEY DATED APRIL 15, 1825 BY S SIBLEY, DS
GLO WITNESSES: S17E-20 LKS-BEECH 18
N36W-22 LKS- SUGAR 11

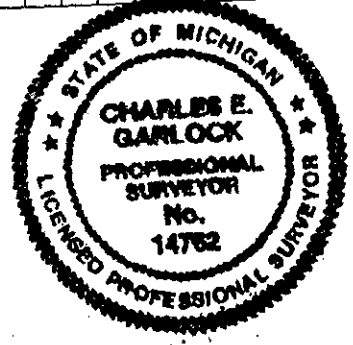

ADDITIONAL DATA ON REAR OF SHEET

B. Description of corner evidence found and/or method applied in restoring or reestablishing corner:
FOUND R.R. SPIKE AND 3/8" I. ROD NEXT NORTH, NO MON BOX, ON CENTERLINE OF ASPHALT NORTH AND SOUTH AND ON CENTERLINE TO THE EAST.
UNDER THE RR SPIKE WE FOUND THE REMAINS OF AN 8" WALK BEHIND PLOW, INCLUDING PLOW POINT, MOLD BOARD AND PART OF THE PLOW FRAME.

C. Description of monument for corner and accessories established to perpetuate locating the position of the corner:
I8: W 1/4 COR. SEC. 23 T3N-R3E, HANDY TWP. LIV. CO. MI, RESET R:R. SPIKE AND 3/8" I. ROD WITH 1 1/2" X 36" BREAKAWAY I. PIPE WITH LIV. CO. REMON BRASS CAP ON TOP. IN A MON BOX
WEST-50.15'-SP & TAG S/S U POLE
S45W-72.27'- SP & TAG N/S U POLE
N40E-60.43'-SP & TAG S/S 8" ELM
N75E-165.54'-SP & TAG S/S 48" OAK
WEST 1'-CTR. ASPHALT ROAD N & S

Signed by Charles E. Garlock
Surveyor's Michigan License No. 14762

Date AUGUST 8, 1998

P.A. 345 1990, APPROVED BY LIVINGSTON COUNTY
PEER GROUP ON 2-18-98, CO. REP JEO