

**SURVEY &
REMONUMENTATION**

FEB 25 1999

SECTION LAND CORNER RECORDATION CERTIFICATE
Filing Requirement of Act 74, Mich. P.A. 1970

FILED

For corners in

<u>LIVINGSTON</u> (County)	Located In:	Corner Code #
1. Public Land Survey	T <u>3N</u> R <u>3E</u>	<u>I9</u>
	T ___ R ___	_____
	T ___ R ___	_____
	T ___ R ___	_____
2. Property Controlling in Section	S ___ T ___	_____
	S ___ T ___	_____
3. Miscellaneous Property in Sec.	S ___ T ___	_____
	S ___ T ___	_____

91
1998 AUG 20 P 4:45
NANCY HAVILAND
REGISTER OF DEEDS
LIVINGSTON COUNTY, MI.
48843
L.S.C. #873m
Register of Deeds Stamp & File Number


4. Lot No. _____, Recorded Plat _____
5. Private Claims _____

I, CHARLES E GARLOCK, in a field survey on AUG 7, 1998 do hereby state that under requirements of P.A. 74, Michigan P.A. of 1970, the corner points mentioned in lines 1 and 2 above were in conformance with regulations and rules therefore as required in the current manual of survey instructions of the United States Department of the Interior, Bureau of Land Management or by a decree of a Court of Law and/or that the corner points mentioned in lines 3, 4 and 5 above were in conformance with the rules of the Michigan Board of Land Surveyors or by a Decree of a Court of Law; established, re-established, monumented, recovered, found as expressed below:

NOTE: Not more than 2 corners, all in the same town and range, may be recorded on this certificate.

1	A	B	C	D	E	F	G	H	I	J	K	L	M
2		6		5		4		3		2		1	
3													
4		7		8		9		10		11		12	
5													
6		10		17		16		15		14		13	
7													
8		19		20		21		22		23		24	
9													
10		30		29		28		27		26		25	
11													
12		31		32		33		34		35		36	
13													

A. Description of original monument and accessories and/or subsequent restoration:
GLO SURVEY DATED: APRIL 15, 1825 BY S SIBLEY, DS
GLO WITNESSES B ASH 10-S89E-22 LKS
BEECH 7-N32W-14 LKS

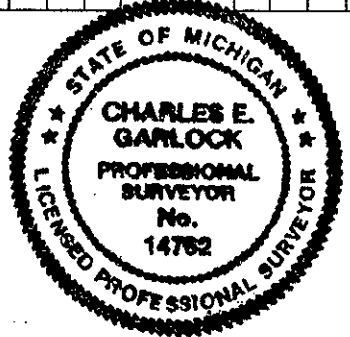

ADDITIONAL DATA ON REAR OF SHEET:

B. Description of corner evidence found and/or method applied in restoring or reestablishing corner:
FOUND 1/2" I. ROD IN AN I. PIPE ON CENTERLINE OF ASPHALT ROAD, TREE ROW TO THE EAST AND NO OCCUPATION TO THE WEST.

C. Description of monument for corner and accessories established to perpetuate locating the position of the corner:
I9: SW COR. SEC. 23, T3N-R3E, HANDY TWP. LIV. CO. MI, RESET 1/2" I. ROD AND I. PIPE WITH 1 1/4" X 36" BREAKAWAY I. PIPE WITH LIV. CO. REMON. BRASS CAP ON TOP. IN A MON. BOX.
WEST-52.66'-SP & TAG N/S U POLE
N85E-34.97'-SP & TAG S/S DBL 8"-12 HICKORY
S80E-34.08'-SP & TAG N/S 9" HICKORY
S10E-118.80'-SP & TAG W/S 30" HICKORY

Signed by Charles E. Garlock Date AUGUST 8, 1998
Surveyor's Michigan License No. 14762