

SURVEY & REMONUMENTATION

FEB 25 1999

SECTION

LAND CORNER RECORDATION CERTIFICATE
Filing Requirement of Act 74, Mich. P.A. 1970

FILED

For corners in

LIVINGSTON
(County)

Located In:

Corner Code #

1. Public Land Survey

T3N	R3E	T10
T	R	
T	R	
T	R	
S	T	R
S	T	R
S	T	R
S	T	R

2. Property Controlling in Section

3. Miscellaneous Property in Sec.

4. Lot No. _____, Recorded Plat _____
5. Private Claims _____


9-
1998 AUG 20 P 4:45
NANCY HAVILAND
REGISTER OF DEEDS
LIVINGSTON COUNTY, MI.
48843
L.S.C. #874m
Register of Deeds Stamp & File Number

CHARLES E GARLOCK, in a field survey on AUG 7, 1998 do hereby state that under requirements of P.A. 74, Michigan P.A. of 1970, the corner points mentioned in lines 1 and 2 above were in conformance with regulations and rules therefore as required in the current manual of survey instructions of the United States Department of the Interior, Bureau of Land Management or by a decree of a Court of Law and/or that the corner points mentioned in lines 3, 4 and 5 above were in conformance with the rules of the Michigan Board of Land Surveyors or by a Decree of a Court of Law; established, re-established, monumented, recovered, found as expressed below:

NOTE: Not more than 2 corners, all in the same town and range, may be recorded on this certificate.

A	B	C	D	E	F	G	H	I	J	K	L	M
1												
2	6	5	4	3	2	1						
3												
4	7	8	9	10	11	12						
5												
6	18	17	16	15	14	13						
7												
8	19	20	21	22	23	24						
9												
10	30	29	28	27	26	25						
11												
12	31	32	33	34	35	36						
13												

A. Description of original monument and accessories and/or subsequent restoration:
GLO SURVEY DATED: APRIL 15, 1825 BY S SIBLEY, DS
GLO WITNESSES: MAPLE 12-S57E-27 LKS
IRONWOOD 6-N44W-7 LKS

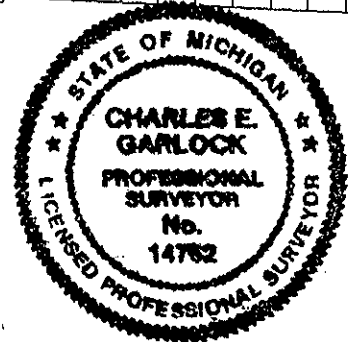

ADDITIONAL DATA ON REAR OF SHEET

B. Description of corner evidence found and/or method applied in restoring or reestablishing corner:
FOUND BOAT SPIKE ON CENTERLINE OF ASPHALT ROAD NORTH & SOUTH AND A 1/2" I. ROD 2.35' TO THE EAST OF SAID BOAT SPIKE., BOAT SPIKE ON THE SPLIT OF ROAD SIDE FENCES AND VERY NEAR THE SPLIT OF 1/4 MILE EAST AND WEST. OCCUPATION TREE ROW TO WEST AND EDGE OF LAWN TO EAST.

C. Description of monument for corner and accessories established to perpetuate locating the position of the corner:
I10: W 1/4 COR. SEC. 26, T3N-R3E, HANDY TWP. LIV. CO. MI., RESET BOAT SPIKE WITH 1 1/4" X 36" BREAKAWAY I. PIPE WITH A LIV. CO. REMON. BRASS CAP ON TOP. IN A MON. BOX
EAST-33.00'- 1/2" I. ROD SET BY D HUGHES
N20E-54.10'-SP & TAG W/S 22" WALNUT
WEST-25.03'-SP & TAG N/S 4-10" MAPLES
S20W-92.92'-SP & TAG E/S 8" ELM
N20W-116.15'-SP & TAG E/S 36" MAPLE
EAST-2.35'-1/2" I. ROD

Signed by Charles E. Garlock
Surveyor's Michigan License No. 14762

Date AUGUST 8, 1998

PA. 345 1980, APPROVED BY LIVINGSTON COUNTY
PEER GROUP ON 3-18-98 CO. REP ✓