

**SURVEY &
REMONUMENTATION**

FEB 25 1999

**LAND CORNER RECORDATION CERTIFICATE
Filing Requirement of Act 74, Mich. P.A. 1970**

FILED

For corners in **SECTION**

<u>LIVINGSTON</u> (County)	Located In:	Corner Code #
1. Public Land Survey	T <u>3N</u> R <u>3E</u>	<u>T12</u>
	T ___ R ___	_____
	T ___ R ___	_____
	T ___ R ___	_____
2. Property Controlling in Section	S ___ T ___ R ___	_____
	S ___ T ___ R ___	_____
3. Miscellaneous Property in Sec.	S ___ T ___ R ___	_____
	S ___ T ___ R ___	_____

9/ 1998 AUG 20 P 4:45
 NANCY HAVILAND
 REGISTER OF DEEDS
 LIVINGSTON COUNTY, MI.
 48843
 L.S.C. #876m
 Register of Deeds Stamp & File Number


4. Lot No. _____, Recorded Plat _____
 5. Private Claims _____

I, CHARLES E GARLOCK, in a field survey on AUG 10, 1998 do hereby state that under requirements of P.A. 74, Michigan P.A. of 1970, the corner points mentioned in lines 1 and 2 above were in conformance with regulations and rules therefore as required in the current manual of survey instructions of the United States Department of the Interior, Bureau of Land Management or by a decree of a Court of Law and for that the corner points mentioned in lines 3, 4 and 5 above were in conformance with the rules of the Michigan Board of Land Surveyors or by a Decree of a Court of Law; established, re-established, monumented, recovered, found as expressed below:

1	A	B	C	D	E	F	G	H	I	J	K	L	M
2	6		5		4		3		2		1		
3													
4	7		8		9		10		11		12		
5													
6	18		17		16		15		14		13		
7													
8	19		20		21		22		23		24		
9													
10	30		29		28		27		26		25		
11													
12	31		32		33		34		35		36		
13													

NOTE: Not more than 2 corners, all in the same town and range, may be recorded on this certificate.

A. Description of original monument and accessories and/or subsequent restoration:
 GLO SURVEY DATED: APRIL 15, 1825 BY S SIBLEY, DS
 GLO WITNESSES: MAPLE 12-S76E-19 LKS
 BEECH 8-S83W-12 LKS

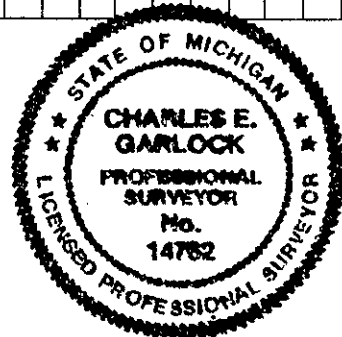

ADDITIONAL DATA ON REAR OF SHEET

B. Description of corner evidence found and/or method applied in restoring or reestablishing corner:
 FOUND 1" IRON IN A MON. BOX ON CENTERLINE OF ASPHALT ROAD AND INLINE WITH GOOD OCCUPATION EAST AND WEST.

C. Description of monument for corner and accessories established to perpetuate locating the position of the corner:
 I12: W 1/4 COR. SEC. 35, T3N-R3E, HANDY TWP. LIV. CO. MI., RESET 1" IRON WITH 1 1/4" X 36" BREAKAWAY I. PIPE WITH LIV. CO. REMON. BRASS CAP ON TOP
 N40E-35.62'-SP & TAG S/S 36" MAPLE
 EAST-47.31'-SP & TAG N/S 7" OAK
 N60W-113.12'-SE COR. OF BRICK FRONT HOUSE
 S70W-124.14'-NE COR. OF BRICK FRONT GARAGE
 EAST-0.5'-CTR. OF FOWLerville ROAD

Signed by Charles E. Garlock Date AUG 11, 1998
 Surveyor's Michigan License No. 14762