

SURVEY & REMONUMENTATION

FEB 24 1998

SECTION

LAND CORNER RECORDATION CERTIFICATE
Filing Requirement of Act 74, Mich. P.A. 1970

FILED

For corners in

LIVINGSTON

(County)

Located In:

Corner Code #

91

- | | | |
|------------------------------------|--|-------------|
| 1. Public Land Survey | T <u>3N</u> R <u>3E</u> | <u>I-13</u> |
| | T <u> </u> R <u> </u> | <u> </u> |
| | T <u> </u> R <u> </u> | <u> </u> |
| | T <u> </u> R <u> </u> | <u> </u> |
| 2. Property Controlling in Section | S <u> </u> T <u> </u> R <u> </u> | <u> </u> |
| | S <u> </u> T <u> </u> R <u> </u> | <u> </u> |
| 3. Miscellaneous Property in Sec. | S <u> </u> T <u> </u> R <u> </u> | <u> </u> |
| | S <u> </u> T <u> </u> R <u> </u> | <u> </u> |

1997 AUG 27 P 12:33

NANCY HAVILAND
REGISTER OF DEEDS
LIVINGSTON COUNTY, MI.
48843

L.S.C. #697m

Register of Deeds Stamp & File Number

4. Lot No. _____, Recorded Plat _____
5. Private Claims _____

I, CHARLES E. GARLOCK, in a field survey on AUG. 8, 1997 do hereby state that under requirements of P.A. 74, Michigan P.A. of 1970, the corner points mentioned in lines 1 and 2 above were in conformance with regulations and rules therefore as required in the current manual of survey instructions of the United States Department of the Interior, Bureau of Land Management or by a decree of a Court of Law and/or that the corner points mentioned in lines 3, 4 and 5 above were in conformance with the rules of the Michigan Board of Land Surveyors or by a Decree of a Court of Law, established, re-established, monumented, recovered, found as expressed below:

NOTE: Not more than 2 corners, all in the same town and range, may be recorded on this certificate.

	A	B	C	D	E	F	G	H	I	J	K	L	M
1													
2		6		5		4		3		2		1	
3													
4		7		8		9		10		11		12	
5													
6		18		17		16		15		14		13	
7													
8		19		20		21		22		23		24	
9													
10		30		29		28		27		26		25	
11													
12		31		32		33		34		35		36	
13													

A. Description of original monument and accessories and/or subsequent restoration:

GLO SURVEY DATED APRIL 15, 1825 BY S SIBLEY AND NONE OF THE GLO WITNESSES REMAIN.
GLO WITNESSES: ASPIN 14-N75W-24 LKS
RO-13-N35E-42 LKS


ADDITIONAL HISTORICAL DATA ON REAR OF SHEET

B. Description of corner evidence found and/or method applied in restoring or reestablishing corner:

FOUND 1/2" I. ROD IN MON. BOX IN CENTER OF WEST BOUND LANE OF MASON ROAD AND 2 FT. WEST OF FOWLerville ROAD TO THE NORTH, FOWLerville ROAD C/L.

C. Description of monument for corner and accessories established to perpetuate locating the position of the corner:

I-13: SE COR. SEC. 34 T3N-R3E, HANDY TWP. LIV. CO. MI., RESET ABOVE FOUND IRON ROD WITH 1 1/4" X 36" BREAKAWAY I, PIPE WITH LIV. CO. REMON BRASS CAP ON TOP AT -0.5' IN MON. BOX
N47W-159.42'-SE COR. CONC. BLOCK BLDG.
N18W-149.25'-SP & TAG E/S U. POLE
S25E-145.17'-NW COR. WOOD SIDING BLDG.,
S5W-62.76'-SP & TAG W/S 40" BOX ELDER
S60W-58.07'-SP & TAG SE/S 40" BOX ELDER
WEST-2'-C/L FOWLerville ROAD TO NORTH
NORTH-5'-C/L MASON ROAD E & W

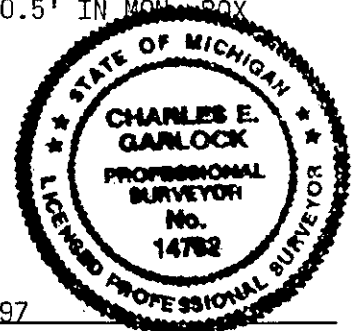

Signed by Charles E. Garlock
Surveyor's Michigan License No. 14762

Date AUGUST 23, 1997

CHARLES E. GARLOCK


PROFESSIONAL SURVEYOR

705 N. MICHIGAN AVE.

HOWELL, MICHIGAN 48843

OFFICE: (517) 546-3340

FAX: 517 546-2941

 

FEBRUARY 13, 1997

CORNER SUMMARY

I-13: SE COR. SEC. 34, T3N-R3E, HANDY TWP. LIV. CO. MI

GLO SURVEY DATED APRIL 15, 1825 BY S SIBLEY AND NONE OF THE GLO WITNESSES REMAIN.

GRANTS 1878 AND BULLOCKS 1879 WITNESS TREE (SAME TREE) IS GONE. IN 1958 MUNSELL FOUND/SET A SPIKE 6' SOUTH OF MASON ROAD CENTERLINE AND HIS REMAINING ONE WITNESS CHECKS. SINCE THEN THE SPIKE AND LATER 1/2" I. ROD IN A MON BOX HAS BEEN WITNESSED BY MUNSELL '61, NEWTON & GARLOCK '72, HUGHES '89, & BOSS '91 AND THEIR REMAINING WITNESSES ALSO CHECK. WE FOUND A 1/2" I. ROD IN A MON. BOX ABOUT 5' SOUTH OF THE CENTERLINE OF MASON ROAD AND 3' EAST OF THE CENTERLINE OF FOWLerville ROAD TO THE NORTH. THE GLO JOG IS 119.46 EAST AND WE FOUND A RR SPIKE 184.76 EAST INLINE WITH A FENCE LINE TO THE SOUTH. MEASURES WEST ARE: 2647.69-NEWTON '72, 2648.12-BOSS '80, 2647.95-GARLOCK '83, 2647.99-HUGHES '89, 2647.93-BOSS '91 AND WE HAD 2647.97 IN '97. MEASURES EAST ARE: 2659.80 AND 2663.76-OLD SURVEY NOTES, 2654.02-BOSS '94 AND WE HAD 2654.11 IN '97. SITE IS GOOD FOR GPS, BUT TRAFFIC IS HEAVY. RECOMMEND CONTINUED USE OF THIS CORNER AS FOUND.

Charles E. Garlock
CHARLES E GARLOCK
PS 14762
HAN97113

SUCCESSOR TO:

- MILES W. BULLOCK, L.S. (1844 TO 1926) ● GRANT H DUNNING, P.E. (1865 TO 1928)
- CLAY W. GORDON, RLS (1883 TO 1970) ● LYLE W. MUNSELL, RLS (1904 TO 1987)

3N/3E I-13 4