

MAR 17 2000

FILED

SECTION

LAND CORNER RECORDATION CERTIFICATE
Filing Requirement of Act 74, Mich. P.A. 1970

1999 NOV 22 A 11:12

For corners in

LIVINGSTON
(County)

Located In: Corner Code #

- 1. Public Land Survey T3N R3E J 3
 T R
 T R
 T R
- 2. Property Controlling S T R
 in Section S T R
- 3. Miscellaneous S T R
 Property in Sec. S T R

9
Seg. 2

HANCY HAVILAND
REGISTER OF DEEDS
LIVINGSTON COUNTY, MI.
48843

LSC# 1154m
Register of Deeds Stamp & File Number


- 4. Lot No. _____, Recorded Plat _____
- 5. Private Claims _____

	A	B	C	D	E	F	G	H	I	J	K	L
1												
2	6		5		4		3		2		1	
3										●		
4	7		8		9		10		11		12	
5												
6	18		17		16		15		14		13	
7												
8	19		20		21		22		23		24	
9												
10	30		29		28		27		26		25	
11												
12	31		32		33		34		35		36	
13												

I, CHARLES E. GARLOCK, in a field survey on NOV. 03, 1999 do hereby state that under requirements of P.A. 74, Michigan P.A. of 1970, the corner points mentioned in lines 1 and 2 above were in conformance with regulations and rules therefore as required in the current manual of survey instructions of the United States Department of the Interior, Bureau of Land Management or by a decree of a Court of Law and for that the corner points mentioned in lines 3, 4 and 5 above were in conformance with the rules of the Michigan Board of Land Surveyors or by a Decree of a Court of Law; established, re-established, monumented, recovered, found as expressed below:

NOTE: Not more than 2 corners, all in the same town and range, may be recorded on this certificate.

A. Description of original monument and accessories and/or subsequent restoration:
 GLO DATED APRIL 15, 1825 BY S SIBLEY AND NONE OF THE GLO WITNESSES REMAIN.
 GLO WITNESS: W026-S66½W-28.38'
 W013-N28½W-31.68'

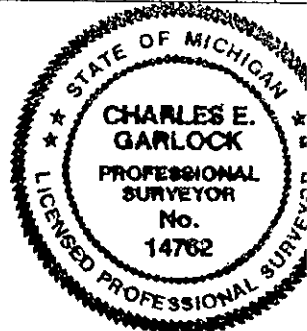

B. Description of corner evidence found and/or method applied in restoring or reestablishing corner:
 FOUND 1/2" I. ROD ABOVE A FOUND PLOW POINT. PLOW POINT IN MC CREARY'S 1900 DESCRIPTION OF THIS CORNER. ALSO FOUND 1/2" I. ROD SET BY BOSS ENGR. IN 1980, LOCATED 15.23' EASTERLY OF THE ABOVE FOUND IRON AND PLOW POINT. OLD OCCUPATION LINES TO THE NORTH AND SOUTH COME CLOSER TO MATCHING THE MC CREARY PLOW POINT THAN THE BOSS ENGR. IRON.

C. Description of monument for corner and accessories established to perpetuate locating the position of the corner:
 N 1/4 COR. SEC. 11 T3N-R3E, HANDY TWP. LIV. CO. MI, REPLACED FOUND 1/2" I. ROD WITH 1½" X 36" BREAKAWAY I. PIPE W/LIV. CO. REMON CAP ON TOP #14762. LEFT PLOW POINT IN POSITION BELOW I. PI ALSO SET IN MON. BOX.
 S50E-60.38'-SP & TAG N.SIDE 16" ELM
 S25W-36.66'-SP & TAG W/SIDE 19" OAK
 S5E-43.95'-SP & TAG W/SIDE DBL POPLAR
 N75E-57.88'-SP & TAG S/SIDE U. POLE
 SOUTH-3'-C/L SHARP ROAD (ASPHALT)

"NOTE": ABOVE WITNESSES SUPERCEDE L.S.C. #1003m, RECORDED MAY 21, 1999. L.S.C. #1003m WITNESSES WERE TO I. ROD SET BY BOSS ENGR.
 Signed by [Signature] Date NOV. 15, 1999
 Surveyor's Michigan License No. 14762

PA. 345 1980, APPROVED BY LIVINGSTON COUNTY
 PEER GROUP ON 3-3-99, CO. REP JED