

**SURVEY & REMONUMENTATION**

FEB 25 1999

**LAND CORNER RECORDATION CERTIFICATE**  
Filing Requirement of Act 74, Mich. P.A. 1970

**FILED**

For corners in **SECTION**

LIVINGSTON Located In: Corner Code #  
(County)

1. Public Land Survey T3N R3E J11  
T R  
T R  
T R

2. Property Controlling in Section S T R  
S T R

3. Miscellaneous Property in Sec. S T R  
S T R

9-

1998 AUG 20 P 4:44

NANCY HAVILAND  
REGISTER OF DEEDS  
LIVINGSTON COUNTY, MI.  
48843

L.S.C. #870m

Register of Deeds Stamp & File Number

4. Lot No. \_\_\_\_\_, Recorded Plat \_\_\_\_\_  
5. Private Claims \_\_\_\_\_


I, CHARLES, E GARLOCK, in a field survey on AUG. 3, 19 98 do hereby state that under requirements of P.A. 74, Michigan P.A. of 1970, the corner points mentioned in lines 1 and 2 above were in conformance with regulations and rules therefore as required in the current manual of survey instructions of the United States Department of the Interior, Bureau of Land Management or by a decree of a Court of Law and for that the corner points mentioned in lines 3, 4 and 5 above were in conformance with the rules of the Michigan Board of Land Surveyors or by a Decree of a Court of Law; established, re-established, monumented, recovered, found as expressed below:

NOTE: Not more than 2 corners, all in the same town and range, may be recorded on this certificate.

	A	B	C	D	E	F	G	H	I	J	K	L	M
1													
2	6		5		4		3		2		1		
3													
4	7		8		9		10		11		12		
5													
6	18		17		16		15		14		13		
7													
8	19		20		21		22		23		24		
9													
10	30		29		28		27		26		25		
11													
12	31		32		33		34		35		36		
13													

A. Description of original monument and accessories and/or subsequent restoration:

GLO SURVEY DATED: APRIL 15, 1825 BY S SIBLEY, DS  
GLO WITNESSES: B ASH 8-S32W-94 LKS  
SUGAR 8-N47W-200 LKS

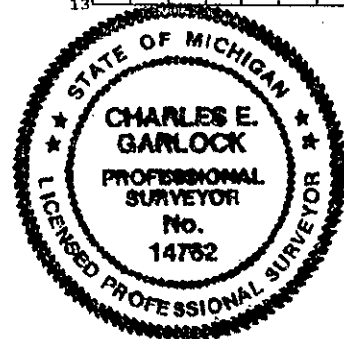

ADDITIONAL DATA ON REAR OF SHEET

B. Description of corner evidence found and/or method applied in restoring or reestablishing corner:

FOUND 1/2" I. PIPE WITH DELTA CAP WHICH LINES WITH THE REMAINS OF A FENCE LINE TO THE SOUTH AND AT A POINT THAT IS THE DOUBLE OF THE TWO 1/8 DISTANCE FROM THE EAST, ALSO FOUND A 1.2" I. ROD 10.0' WEST OF THE ABOVE THAT LINE WITH THE ROAD CENTERLINE TO THE NORTH.

C. Description of monument for corner and accessories established to perpetuate locating the position of the corner:

J11: S 1/4 COR. SEC. 26, T3N-R3E, HANDY TWP. LIV. CO. MI., RESET 1/2" I. PIPE WITH DELTA CAP WITH 1 1/4 X 36" BREAKAWAY I. PIPE WITH LIV. CO. REMON BRASS CAP ON TOP.  
S65E-81.64'-SP & TAG N/S 8" DBL MAPLE  
S28E-34.70'-SP & TAG W/S TRIPLE 8" MAPLE  
S66W-56.10'-SP & TAG N/S 12" ASH  
N25W-62.71'-SP & TAG N/S U. POLE

Signed by Charles E. Garlock  
Surveyor's Michigan License No. 14762

Date AUGUST 8, 1998