

SURVEY & REMONUMENTATION

FEB 24 1998

SECTION

LAND CORNER RECORDATION CERTIFICATE
Filing Requirement of Act 74, Mich. P.A. 1970

FILED

For corners in
LIVINGSTON
(County)

Located In:

Corner Code # 9-

1. Public Land Survey	T <u>3N</u> R <u>3E</u>	<u>J-13</u>
	T <u> </u> R <u> </u>	<u> </u>
	T <u> </u> R <u> </u>	<u> </u>
	T <u> </u> R <u> </u>	<u> </u>
2. Property Controlling in Section	S <u> </u> T <u> </u> R <u> </u>	<u> </u>
	S <u> </u> T <u> </u> R <u> </u>	<u> </u>
3. Miscellaneous Property in Sec.	S <u> </u> T <u> </u> R <u> </u>	<u> </u>
	S <u> </u> T <u> </u> R <u> </u>	<u> </u>

1997 AUG 27 P 12:33

NANCY HAVILAND
REGISTER OF DEEDS
LIVINGSTON COUNTY, MI.
48843

L.S.C. #698m

Register of Deeds Stamp & File Number

4. Lot No. _____, Recorded Plat _____
5. Private Claims _____

I, CHARLES E. GARLOCK in a field survey on AUG. 8, 1997 do hereby state that under requirements of P.A. 74, Michigan P.A. of 1970, the corner points mentioned in lines 1 and 2 above were in conformance with regulations and rules therefore as required in the current manual of survey instructions of the United States Department of the Interior, Bureau of Land Management or by a decree of a Court of Law and for that the corner points mentioned in lines 3, 4 and 5 above were in conformance with the rules of the Michigan Board of Land Surveyors or by a Decree of a Court of Law; established, re-established, monumented, recovered, found as expressed below:

NOTE: Not more than 2 corners, all in the same town and range, may be recorded on this certificate.

	A	B	C	D	E	F	G	H	I	J	K	L	M
1													
2	6		5		4		3		2		1		
3													
4	7		8		9		10		11		12		
5													
6	18		17		16		15		14		13		
7													
8	19		20		21		22		23		24		
9													
10	30		29		28		27		26		25		
11													
12	31		32		33		34		35		36		
13													


A. Description of original monument and accessories and/or subsequent restoration:
GLO SURVEY DATED APRIL 15, 1825 BY S SIBLEY AND NONE OF THE GLO WITNESSES REMAIN
GLO WITNESSES: WO 22-N46W-13 LKS
IRONWOOD 5-N70E-27 LKS

ADDITIONAL HISTORICAL DATA ON REAR OF SHEET

B. Description of corner evidence found and/or method applied in restoring or reestablishing corner:
FOUND RAILROAD SPIKE ON C/L OF MASON ROAD AND FENCE LINE TO THE NORTH

C. Description of monument for corner and accessories established to perpetuate locating the position of the corner:
J-13: S 1/4 COR. SEC. 35 T3N-R3E, HANDY TWP. LIV. CO. MI., RESET ABOVE WITH 1 1/4" X 18" BREAK-SET MON. BOX.
S18W-102.95'-SP & TAG E/S 12" CEDAR
S35E-92.35'-SP & TAG W/S 16" PINE
S58W-162.80'-SP 7 TAG W/S 9" CHERRY
N2E-30.90'-C/L 1 1/2" CEDAR
ON C/L OF MASON ROAD
SET SHORTER PIPE WHEN WE HIT A LARGE STONE AT -24"
THAT WE COULD NOT DRILL THROUGH

Signed by Charles E. Garlock Date AUGUST 23, 1997
Surveyor's Michigan License No. 14762

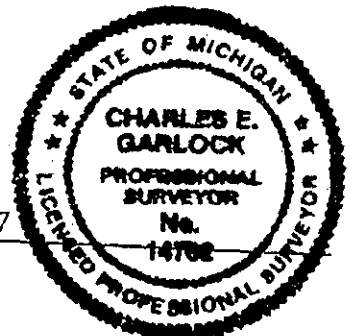

P.A. 345 1990, APPROVED BY LIVINGSTON COUNTY
PEER GROUP ON 2/26/97 CO. REP JED

CHARLES E. GARLOCK

PROFESSIONAL SURVEYOR

705 N. MICHIGAN AVE.

HOWELL, MICHIGAN 48843

OFFICE: (517) 546-3340

FAX: 517 546-2941



FEBRUARY 13, 1997

CORNER SUMMARY

J-13: S 1/4 COR. SEC. 35, T3N-R3E, HANDY TWP. LIV. CO. MI

GLO SURVEY DATED APRIL 15, 1825 BY S SIBLEY AND NONE OF THE GLO WITNESSES REMAIN.

GRANTS 1877 WITNESS TREE IS GONE.

WE FOUND A RR SPIKE ON THE CENTERLINE OF MASON ROAD AND IN LINE WITH AN OLD FENCE LINE TO THE NORTH. BENTON '69 HAD WITNESSED THIS CORNER, CALLING IT A PK SPIKE AND I USED THE SAME WITNESSES TO THE PK SPIKE IN '81; REMAINING WITNESSES CHECK TO THE FOUND RR SPIKE. BOSS HAD MEASURED EAST 153.63 TO THE IOSCO CORNER AND WE FOUND THE MEASURE TO BE 153.71 IN '97, GLO JOG COMPUTES AT 104.61. MEASURES WEST ARE: 2663.76 AND 2659.80-OLD SURVEY NOTES, 2654.02-BOSS '94 AND WE HAD 2654.11 IN '97. MEASURES EAST ARE: 2659.64 AND 2643.30-OLD SURVEY NOTES, 2660.22-BOSS '94 AND WE HAD 2660.29 IN '97.

SITE IS GOOD FOR GPS, BUT TRAFFIC IS HEAVY. RECOMMEND CONTINUED USE OF THE CORNER AS FOUND.

Charles E. Garlock

CHARLES E GARLOCK

PS 14762

HAN97J13

SUCCESSOR TO:

MILES W. BULLOCK, L.S. (1844 TO 1926)

GRANT H DUNNING, P.E. (1865 TO 1928)

CLAY W. GORDON, RLS (1883 TO 1970)

LYLE W. MUNSELL, RLS (1904 TO 1987)

3/15/97 J-13