

LAND CORNER RECORDATION CERTIFICATE
Filing Requirement of Act 74, Mich. P.A. 1970

FILED

For corners in

<u>Livingston</u> (County)	Located In:	Corner Code #
1. Public Land Survey	T <u>3N</u> R <u>3E</u>	<u>K-2</u>
	T <u> </u> R <u> </u>	<u> </u>
	T <u> </u> R <u> </u>	<u> </u>
	T <u> </u> R <u> </u>	<u> </u>
2. Property Controlling in Section	S <u> </u> T <u> </u> R <u> </u>	<u> </u>
	S <u> </u> T <u> </u> R <u> </u>	<u> </u>
3. Miscellaneous Property in Sec.	S <u> </u> T <u> </u> R <u> </u>	<u> </u>
	S <u> </u> T <u> </u> R <u> </u>	<u> </u>

AUG 27 10 25 AM '96

NANCY HAVILAND
REGISTER OF DEEDS
LIVINGSTON COUNTY, MI
48843

L.S.C.#547m

Register of Deeds Stamp & File Number

4. Lot No. _____, Recorded Plat _____
5. Private Claims _____

I, Charles E Garlock, in a field survey on August 21, 1996 do hereby state that under requirements of P.A. 74, Michigan P.A. of 1970, the corner points mentioned in lines 1 and 2 above were in conformance with regulations and rules therefore as required in the current manual of survey instructions of the United States Department of the Interior, Bureau of Land Management or by a decree of a Court of Law and /or that the corner points mentioned in lines 3, 4 and 5 above were in conformance with the rules of the Michigan Board of Land Surveyors or by a Decree of a Court of Law; established, re-established, monumented, recovered, found as expressed below:

A	B	C	D	E	F	G	H	I	J	K	L	M
1												
2	6		5		4		3		2	●	1	
3												
4	7		8		9		10		11		12	
5												
6	18		17		16		15		14		13	
7												
8	19		20		21		22		23		24	
9												
10	30		29		28		27		26		25	
11												
12	31		32		33		34		35		36	
13												

NOTE: Not more than 2 corners, all in the same town and range, may be recorded on this certificate.


A. Description of original monument and accessories and/or subsequent restoration:
GLO Survey dated: April 15, 1825 by S Sibley, Ds
GLO witnesses: Maple 6-N24E-43 Lks
Elm 7-S36W-18 lks

Additional historical data on rear of sheet

B. Description of corner evidence found and/or method applied in restoring or reestablishing corner:
Found 5/8" I. Rod with Verba cap on top 0.4' North of corner post with fence lines to the N., E, and S.

P.A. 345 1990, APPROVED BY LIVINGSTON COUNTY
PEER GROUP ON 3-27-96 CO. REP JED

C. Description of monument for corner and accessories established to perpetuate locating the position of the corner:
K-2: W 1/4 cor. Sec. 1 T3N-R3E, Handy Twp. Liv.Co.MI. Set 1/4" X 36" I. Pipe with Liv. Co. Remon brass cap on top and in place of found iron.
060°-7.90'-sp & tag in SW post of fence 10' high
300°-1.56'-sp & tag S/s 8" oak
282°-13.65'-sp & tag S/s 10" Oak
249°-12.37'-sp & tag S/s 8" Oak
South-8.50'-Sp & tag W/s 7" oak
top of set iron is +1.8' and supported with large stones.

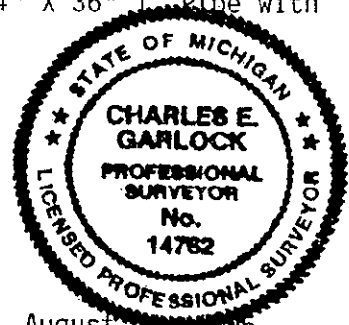

Signed by Charles E Garlock
Surveyor's Michigan License No. 14762

Date August 21, 1996

CORNER SUMMARY

K-2: WEST 1/4 CORNER OF SECTION 1, T3N-R3E, HANDY TOWNSHIP;
LIVINGSTON COUNTY, MICHIGAN.

I TELLER IN 1887 WITNESSED THIS CORNER AND NONE REMAINS. IN 1970 D
VERB SET A 5/8" I. ROD FOR THE CORNER AT A FENCE LINE
INTERSECTION, WHICH HE STATED WAS THE ONLY EVIDENCE HE FOUND FOR
ITS ESTABLISHMENT. REMAINING WITNESSES BY BRYAN, BOSS, VERBA AND
MYSELF CHECK TO THE FOUND 5/8" I. ROD. TWO ACT 74'S AND SIX ACT
132'S ARE RECORDED. MEASURES NORTH ARE: 2082.45 BY BOSS, 2082.99
BY VERBA AND 2098.14 & 2108.04 FROM OLD COUNTY SURVEY RECORDS.
MEASURES EAST ARE: 2624.31 BY VERBA, 2624.96 BY BRYAN AND 2625.15
BY MYSELF. MEASURES SOUTH ARE: 2675.79 BY VERBA, 2676.51 BY
MYSELF AND 2651.88 FROM OLD COUNTY SURVEY RECORDS. CORNER WAS SET
AT THE BASE OF A CORNER POST AND RECOMMEND WE ACCEPT THE CORNER AS
FOUND, BASED ON THE REMAINS OF THE OLD FENCE LINE INTERSECTION.
A GPS SITE MAYBE-BRUSH.



CHARLES E GARLOCK
PS 14762
HAN96K21