

SURVEY & REMONUMENTATION

FILED

9

JUN 29 1995

LAND CORNER RECORDATION CERTIFICATE
 Filing Requirement of Act 74, Mich. P.A. 1970

APR 26 9 44 AM '95

COMMISSION

NANCY HAVILAND
 REGISTER OF DEEDS
 LIVINGSTON COUNTY, MI
 48843

For corners in

Livingston
 (County)

Located In:

Corner Code #

- 1. Public Land Survey T 3N R 3E K-5
 T _____ R _____
 T _____ R _____
 T _____ R _____
- 2. Property Controlling S _____ T _____ R _____
 in Section S _____ T _____ R _____
- 3. Miscellaneous S _____ T _____ R _____
 Property in Sec. S _____ T _____ R _____
- 4. Lot No. _____, Recorded Plat _____
- 5. Private Claims _____

L.S.C. #389m
 Register of Deeds Stamp & File Number

I, Charles E Garlock in a field survey on April 20, 1995 do hereby certify that under requirements of P.A. 74, Michigan P.A. of 1970, the corner points mentioned in lines 1 and 2 above were in conformance with regulations and rules therefore as required in the current manual of survey instructions of the United States Department of the Interior, Bureau of Land Management or by a decree of a Court of Law and/or that the corner points mentioned in lines 3, 4 and 5 above were in conformance with the rules of the Michigan Board of Land Surveyors or by a Decree of a Court of Law; established, re-established, monumented, re-monumented, recovered, found as expressed below:

NOTE: Not more than 4 corners, all in the same town and range, may be recorded on this certificate.

	A	B	C	D	E	F	G	H	I	J	K	L	M
2	6	5	4	3	2	1							
3													
4	7	8	9	10	11	12							
5													
6	18	17	16	15	14	13							
7													
8	19	20	21	22	23	24							
9													
10	30	29	28	27	26	25							
11													
12	31	32	33	34	35	36							
13													


A. Description of original monument and accessories and/or subsequent restoration:

GLO survey dated: April 15, 1995 by S Sibley DS
 GLO witnesses: W020-N66E-34 lks
 W024-S85½W-41 lks

Additional historical data on rear of sheet

B. Description of corner evidence found and/or method applied in restoring or reestablishing corner:

Found 3/4" X 16" I. Pipe

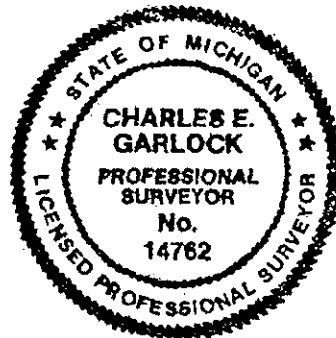

C. Description of monument for corner and accessories established to perpetuate locating the position of the corner:

K-5: Northwest corner Section 13, T3N-R3E, Handy Twp. Liv. Co. MI; re-set 3/4" I. Pipe with 1 1/4" X 36" breakaway I. Pipe with Liv. Co. Remon brass cap on top at -0.5'
 East-33.53'-Conc. Mon.
 S70E-45.69'-sp & tag N/s 12" Spruce
 N75E-38.21'-sp & tag S/s 10" Pime
 N40E-49.45'-sp & tag S/s 10" Maple
 N10W-127.79'-sp & tag W/s U. Pole
 corner is on c/l of North-South Road

PA 345 1980, APPROVED BY LIVINGSTON COUNTY
 PEER GROUP ON 3/1/95 CO. REP JED

Signed by Charles E. Garlock
 Surveyor's Michigan License No. 14762

Date April 20, 1995

CORNER SUMMARY


K-5: GLO SURVEY DATED APRIL 15, 1825 BY S SIBLEY, NONE OF THE GLO WITNESSES REMAIN.

EARLY WITNESSES BY E GRANT (1878) AND I TELLER (1888) ARE GONE. MDOT IN 1937 HAD WITNESSES TO A 3/4" I. PIPE AS DID C GORDON IN 1939. SINCE THAT TIME TO PRESENT SURVEYS AND WITNESSES BY BENTON, BOSS, HUGHES, MUNSELL, MDOT AND MYSELF HAVE BEEN TO A 3/4" I. PIPE AND ALL WITNESSES THAT REMAIN CHECKED WITH THE NOW FOUND 3/4" I. PIPE IN THE CENTERLINE OF A GRAVEL ROAD, ON LINE WITH A FENCE TO THE EAST AND LINES WITH AN OCCUPATION LINE TO THE WEST. MEASURES EAST TO THE N 1/4 COR.: 2626.47 FT. BY E GRANT, 2626.02 BY HUGHES, 2626.16 BY BOSS AND 2630.70 BY BENTON. SOUTH TO THE W 1/4 CORNER: 2658.15 FT. BY E GRANT, 2661.90 BY MYSELF AND 2661.85 BY BENTON. ALSO FOUND A CONCRETE MONUMENT 33.00 FT. EAST AND 218.00 FEET EAST FOR POINTS ON THE NORTH BOUNDARY OF "HARMONY LANE" SUB. FOUND ONE ACT 74 RECORDED AND 10 ACT 132'S. CORNER IS CLEAR FOR GPS OBSERVATION EXCEPT E'LY.

Charles E. Garlock

CHARLES E GARLOCK
PS14762

K5HAN95

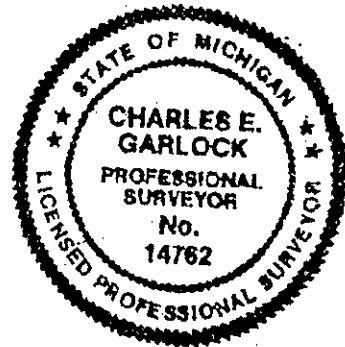

31-35 10-5

FILED

