For corners in Livingston (County)	Filing Require Located In:	ement of Act 74, Mich. Corner Code ##	P.A. 1970		LIVINGSTON CO	NANCY HAN	SEP 3 28		FRICE	
 Public Land Survey Property Controlling in Section Miscellaneous 	T 3N R 3E T R T R S T R	K-8	L.S.C.		m X		15. Hd.		9	
Property in Sec.	S T R		negi	ster of D	eeas S	amp	& FII	Nui	nber	<u></u>
	ecorded Plat			A B	C D E	F	G Н	1 .	K	L N
				2 6-	5	- 	 3 -		-	- -
do hereby certify that under require lines 1 and 2 above were in current manual of survey instructions and the conformance with Court of Law; established, reexpressed below: NOTE: Not more than 4 co on this certificate. A Description of original models of the court of Law; established, reexpressed below: NOTE: Not more than 4 co on this certificate. A Description of original models of the court of the	in a field survey on	of 1970, the corner points mend rules therefore as required ment of the Interior, Bureau or points mentioned in lines 3, if Land Surveyors or by a Dechonumented, recovered, for and range, may be recorded.	ntioned d in the of Land 4 and 5 tree of a und as	4 7 5 6 18 7 8 19 10 30 11 12 31		-16		2 2 3	3-	-121313242536

See additional data on rear of sheet

B. Description of corner evidence found and/or method applied in restoring or reestablishing corner: Found RR spike at -0.5-, Found pointed bolt with 1" square head at -1.3' and found pointed stone with brick around it at -2.3', ALL of which lined vertically.

SURVEY & REMONUMENTATION

SEP 2 6 1994

COMMISSION


C. Description of monument for corner and accessories	established to perpetuate	locating the position of the	corner:
K-8: W 1/4 cor. Sec. 24 T3N-R3E, handy with breakaway top and Liv. Co. Remon bra		eset with (1/4" X.	so i Pipe
N5W-104.20'-sp E/s 24" Scyamore \$704	ass cap on cop.	OF MICH	
N10W-70.32'-sp & tag E/s 8" Elm		A. C.	A
N15E-75.48'-sp & tag W/s 15" Hickory		16/2000	1
S80E-119.10'-sp & tag N/s 40" Oak		CHARLES E. GARLOCK	
N80E-61.84'-PK & washer top C/L of Culver	rt	PROFESSIONAL	2
Corner is at C/L Xing of Smith and Layton		SURVEYOR	₹ 2
4		14762	
	,	A STATE OF THE STA	
		12.3010	
M. Var Mr. M.			
Signed by		August 27,_19	94
Surveyor's Michigan License No14762			
Surveyor's Michigan License No.	P.A. 345 1990, APPROVED	BY LIVINGSTON COUNTY	OARD OF LAND SURVEYORS, JAN. 28, REVISED MAY 14.
	29.1	and and	REVISED JAN.,

PEER GROUP ON 27 Very 94, CO. REP 1966.

K-8: WEST 1/4 CORNER OF SECTION 24, T3N-R3E, HANDY TOWNSHIP, LIVINGSTON COUNTY, MICHIGAN.

GLO SURVEY DATED APRIL 15, 1825 BY S SIBLEY AND NONE OF THE WITNESSES REMAIN.

NEXT KNOWN WITNESSES ARE 1877 AND 78 BY E GRANT, M BULLOCK IN 1882, NONE OF WHICH REMAIN TODAY. C GORDON FOUND A BOLT IN STONE, DATE UNKNOWN. IN 1959 & 60 L MUNSELL FOUND THE BOLT IN STONE AS I DID IN 1981 WHEN IT WAS RAISED WITH A RR SPIKE. ONE WITNESS TO A SYCAMORE BY C GORDON REMAINS TODAY AND STILL CHECKS. ABOUT 1972 C WILSON SET A SECOND RR SPIKE 1.5 FEET WEST AND 0.5 FEET SOUTH OF THE CORNER GORDON, MUNSELL, BENTON, HUGHES AND MYSELF HAVE USED. I FOUND TWO ACT 74'S RECORDED, MINE AND C WILSON'S AND ONE ACT BENTON MEASURED NORTH 2651.97 TO THE NW COR. SECTION 24, HUGHES HAD 2651.80 AND I HAD 2651.74; I MEASURED SOUTH 2648.42 TO THE SW CORNER OF SECTION 24 AND EAST 5243.71 TO THE EAST 1/4 OF SECTION 24. THIS YEAR I FOUND THE RR SPIKE AT -0.5 FEET AND DIRECTLY UNDER IT THE BOLT WITH A 1" TO 1 1/4" SQUARE HEAD SET STONE AS PER C GORDON'S NOTES, THE C WILSON RR SPIKE WAS GONE. THE CORNER IS IN THE INTERSECTION OF LAYTON AND SMITH ROADS (GRAVEL) AND FAIRLY OPEN IN ALL DIRECTIONS. FOUND NO OTHER IRONS IN THE AREA.

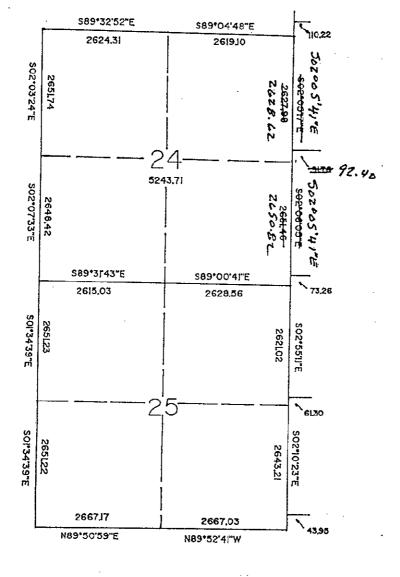

BN-3E K8