

JUN 29 1995

**LAND CORNER RECORDATION CERTIFICATE**  
 Filing Requirement of Act 74, Mich. P.A. 1970

APR 26 9 44 AM '95

**COMMISSION**  
 For corners in

HANGY HAYILAND  
 REGISTER OF DEEDS  
 LIVINGSTON COUNTY, MI  
 48843

Livingston (County) Located in: Corner Code #/

1. Public Land Survey	T <u>3N</u> R <u>3E</u>	<u>L-5</u>
	T _____ R _____	_____
	T _____ R _____	_____
	T _____ R _____	_____
2. Property Controlling In Section	S _____ T _____ R _____	_____
	S _____ T _____ R _____	_____
3. Miscellaneous Property in Sec.	S _____ T _____ R _____	_____
	S _____ T _____ R _____	_____

L.S.C.#388m

Register of Deeds Stamp & File Number

- 4. Lot No. \_\_\_\_\_, Recorded Plat \_\_\_\_\_
- 5. Private Claims \_\_\_\_\_

	A	B	C	D	E	F	G	H	I	J	K	L	M
2	6	5	4	3	2	1							
3													
4	7	8	9	10	11	12							
5													
6	18	17	16	15	14	13							
7													
8	19	20	21	22	23	24							
9													
10	30	29	28	27	26	25							
11													
12	31	32	33	34	35	36							
13													


I, Charles E Garlock, in a field survey on April 20, 19 95, do hereby certify that under requirements of P.A. 74, Michigan P.A. of 1970, the corner points mentioned in lines 1 and 2 above were in conformance with regulations and rules therefore as required in the current manual of survey instructions of the United States Department of the Interior, Bureau of Land Management or by a decree of a Court of Law and/or that the corner points mentioned in lines 3, 4 and 5 above were in conformance with the rules of the Michigan Board of Land Surveyors or by a Decree of a Court of Law; established, re-established, monumented, re-monumented, recovered, found as expressed below:

**NOTE: Not more than 4 corners, all in the same town and range, may be recorded on this certificate.**

- A. Description of original monument and accessories and/or subsequent restoration:  
 GLO survey dated: April 15, 1825 by S Sibley DS:  
 GLO witnesses: B08-N32½W-22 lks  
 B020-S10E-11 lks

Additional historical data on rear of sheet

- B. Description of corner evidence found and/or method applied in restoring or reestablishing corner:  
 Found 1" X 1 1/4" X 16" Iron bar  
3/4"

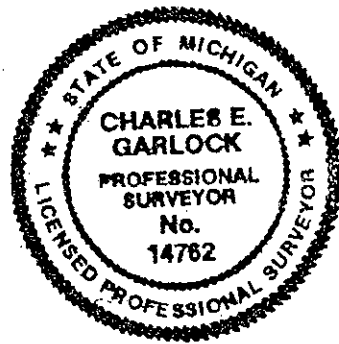

- C. Description of monument for corner and accessories established to perpetuate locating the position of the corner:  
 L-5: North 1/4 corner of Section 13, T3N-R3E, handy Twp. Liv. Co. MI; re-set Iron bar with 1 1/4" X 36" breakaway 1. Pipe with Liv. Co. Remon. brass cap on top at -0.5'  
 East-83.77'-sp & tag S/s 14" W Cherry  
 East-24.25'-face of steel I-beam fence post  
 N65E-59.94'-sp & tage S/s U Pole  
 West-45.63'-sp & tag N/s U Pole  
 S45E-35.45'-sp & tag S/s 5" tree  
 S55E-112.30'-c/l 3" Pine  
 East-6.9'± North-South Road

PA. 345 1990, APPROVED BY LIVINGSTON COUNTY  
 PEER GROUP ON 3/1/95 CO. REP JED

Signed by Charles E Garlock Date April 20, 1995  
 Surveyor's Michigan License No. 14762

CORNER SUMMARY

L-5: N 1/4 COR. SEC. 13, T3N-R3E, HANDY TWP. LIV. CO. MI


GLO SURVEY DATED APRIL 15, 1825 BY S SIBLEY AND NONE OF THE GLO WITNESSES REMAIN.

IN 1878 E GRANT WITNESSED SAID POINT, BUT NONE REMAIN TODAY. NEXT KNOWN SURVEY WAS IN 1962 BY L MUNSELL WHEN HE FOUND A 3/4" X 1" IRON BAR; HIS REMAINING WITNESSES AND SUBSEQUENT WITNESSES BY ALBRIGHT, ANDERSON, BENTON, BOSS, HUGHES AND MYSELF ALL CHECKED TO THE NOW FOUND 3/4" X 1" IRON BAR. BUT A 1/2" I. ROD WAS FOUND IN THE 1970'S BY PL BENTON, 4.6FT. EAST OF THE IRON BAR AND AGAIN BY HUGHES IN 1991 AT 4.71 FT. EAST OF THE NOW BENT IRON BAR. I DID NOT FIND ANY WITNESSES THAT HAVE TIED TO THIS NEWER 1/2" I. ROD, NOR CAN I FIND ANY SURVEYS TIED TO IT (???????) AND IT APPEARS EVERYONE IS USING THE OLDER 3/4" X 1" IRON BAR. MEASURES WEST TO THE NW SEC. COR. ARE: 2626.47 BY E GRANT, 2626.02 BY HUGHES, 2626.16 BY BOSS AND 2630.70 BY BENTON (4.7 FT. LONGER AND THE SAME DISTANCE BETWEEN IRONS AND HIS WITNESSES ARE TO THE OLDER SQUARE BAR ???). EAST TO THE NE COR. OF SEC.: 2635.48 BY BENTON (CALC'D), 2636.36 BY DETROIT EDISON & ALBRIGHT, AND 2617.05 BY M BULLOCK. MEASURES SOUTH TO THE CTR. OF SEC.: 2652.38 BY E GRANT, 2655.54 BY BENTON AND HUGHES AND 2654.16 BY DETROIT EDISON & ALBRIGHT. FOUND TWO ACT 74'S RECORDED AND EIGHT ACT 132'S, ALL TO THE 3/4" X 1" IRON BAR. IRON IS IN A GRAVEL ROAD ABOUT 7 FT. WEST OF THE CENTERLINE AND A GOOD GPS STATION. I WOULD RECOMMEND WE CONTINUE TO USE THE 3/4" X 1" SQUARE BAR THAT EVERYONE HAS WITNESSED.

*Charles E. Garlock*

CHARLES E GARLOCK  
PS 14762

L5HAN95

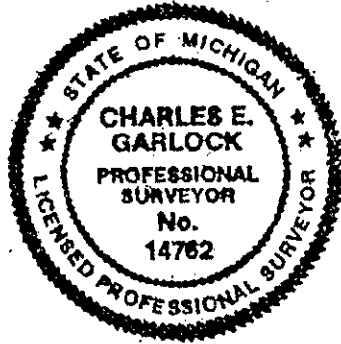

3N-3E  
L5  
4