

SURVEY & REMONUMENTATION

OCT 25 1993

COMMISSION

LAND CORNER RECORDATION CERTIFICATE Filing Requirement of Act 74, Mich. P.A. 1970

For corners in

Livingston
(County)

Located in:

Corner Code ##

- | | | |
|------------------------------------|-------------------------|-------------|
| 1. Public Land Survey | T <u>3N</u> R <u>3E</u> | <u>L-11</u> |
| | T _____ R _____ | _____ |
| | T _____ R _____ | _____ |
| | T _____ R _____ | _____ |
| 2. Property Controlling in Section | S _____ T _____ R _____ | _____ |
| | S _____ T _____ R _____ | _____ |
| 3. Miscellaneous Property in Sec. | S _____ T _____ R _____ | _____ |
| | S _____ T _____ R _____ | _____ |

4. Lot No. _____, Recorded Plat _____
5. Private Claims _____

FILED
 FILED
 AUG 26 9 12 AM '93
 NANCY HAVILLAND
 REGISTER OF DEEDS
 LIVINGSTON COUNTY, MI
 1048843

L.S.C.#. _____
Register of Deeds Stamp & File Number

I, Charles E Garlock, in a field survey on August 24, 19 93

do hereby certify that under requirements of P.A. 74, Michigan P.A. of 1970, the corner points mentioned in lines 1 and 2 above were in conformance with regulations and rules therefore as required in the current manual of survey instructions of the United States Department of the Interior, Bureau of Land Management or by a decree of a Court of Law and/or that the corner points mentioned in lines 3, 4 and 5 above were in conformance with the rules of the Michigan Board of Land Surveyors or by a Decree of a Court of Law; established, re-established, monumented, re-monumented, recovered, found as expressed below:

NOTE: Not more than 4 corners, all in the same town and range, may be recorded on this certificate.

A. Description of original monument and accessories and/or subsequent restoration:
 GLO notes: W 0 10-S12E-36 lks
 B Ash 9-N57½W-46 Lks
 None of the original or subsequent witnesses found.


GLO notes April 15, 1825 S. Sibley

B. Description of corner evidence found and/or method applied in restoring or reestablishing corner:
 Found 1/2" I. Rod that is on the split of the mile between NW and NE Section corners within 0.07 ft. and lines with old occupation lines North and South.
 Matches witnesses in Act 74 Rec. L.S.C. 183 Liv. Co. Rec. May 23, 1972

C. Description of monument for corner and accessories established to perpetuate locating the position of the corner:
 North-20.47'-spike E/side 40" Ash
 N45E-24.84'-spike E/side 18" Oak
 N60E-38.82'-spike SE/side 18" Oak
 S60W-42.79'-spike N/side 24" Willow
 North-1.0'±-ctr. of Road East & West.
 Set 1 1/4" X 18" I. Pipe over 1/2" X 30" I. Rod and raised with 1 1/4" X 6" I. Pipe with brass cap marked: Liv. Co. Mon. Cor.

APPROVED by Livingston County Monumentation Peer Group, July 21, 1993

Signed by *Charles E Garlock* Date August 25, 1993
 Surveyor's Michigan License No. 14762

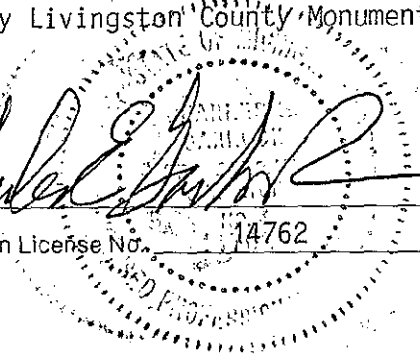

10/26/93

	A	B	C	D	E	F	G	H	I	J	K	L	M
2	6		5		4		3		2		1		
3													
4	7		8		9		10		11		12		
5													
6	18		17		16		15		14		13		
7													
8	19		20		21		22		23		24		
9													
10	30		29		28		27		26		25		
11													
12	31		32		33		34		35		36		
13													