

OCT 25 1993

LAND CORNER RECORDATION CERTIFICATE
Filing Requirement of Act 74, Mich. P.A. 1970

SEP 27 8 38 AM '93

COMMISSION
For corners in

Livingston
(County)

Located In:

Corner Code ##

- 1. Public Land Survey T 3N R 3E L-13
T _____ R _____
T _____ R _____
T _____ R _____
- 2. Property Controlling S _____ T _____ R _____
In Section S _____ T _____ R _____
- 3. Miscellaneous S _____ T _____ R _____
Property in Sec. S _____ T _____ R _____

NANCY HAVILAND
REGISTER OF DEEDS
LIVINGSTON COUNTY, MI
48843

L.S.C. #9m

Register of Deeds Stamp & File Number

- 4. Lot No. _____, Recorded Plat _____
- 5. Private Claims _____

	A	B	C	D	E	F	G	H	I	J	K	L	M
2	6	5	4	3	2	1							
3													
4	7	8	9	10	11	12							
5													
6	18	17	16	15	14	13							
7													
8	19	20	21	22	23	24							
9													
10	30	29	28	27	26	25							
11													
12	31	32	33	34	35	36							
13													

I, Charles E Garlock, in a field survey on September 24, 1993

do hereby certify that under requirements of P.A. 74, Michigan P.A. of 1970, the corner points mentioned in lines 1 and 2 above were in conformance with regulations and rules therefore as required in the current manual of survey instructions of the United States Department of the Interior, Bureau of Land Management or by a decree of a Court of Law and/or that the corner points mentioned in lines 3, 4 and 5 above were in conformance with the rules of the Michigan Board of Land Surveyors or by a Decree of a Court of Law; established, re-established, monumented, re-monumented, recovered, found as expressed below:

NOTE: Not more than 4 corners, all in the same town and range, may be recorded on this certificate.

A. Description of original monument and accessories and/or subsequent restoration:
GLO Witnesses to South 1/4 Cor. Sec. 36 (L-13)
WO 13-N43 1/2 W-5 lks; WO 12-N70 1/2 E-13 lks.

See reverse side for corner summary of reseach.


GLO notes dated: April 15, 1825, Sylvester Sibley

B. Description of corner evidence found and/or method applied in restoring or reestablishing corner:
Found PK spike from previous witnesses and surveys by Lyle W Munsell and myself.

C. Description of monument for corner and accessories established to perpetuate locating the position of the corner:
Reset with 1 1/4" X 36" I. Pipe with Liv. Co. Monumentation cap in Mon Box at (-0.5')
North-34.12'-face 15" dia Conc. post tipped North (at grd)
N60E-74.43'-1" I. Pipe w/Brass cap; stamped "Witness"
S60E-77.23'-1" I. Pipe w/brass cap stamped "Witness"
S60W-44.29'-1" I. Pipe w/brass cap stamped "Witness"
East-54.00'-PK spike next to R.R. spike, N 1/4 cor. Sec. 1 T2N-R3E Iosco Twp.
South-1'±-ctr. of Mason Rd.
Lines with fence line to North

APPROVED by Livingston County Monumentation Peer Group July 21, 1993

Signed by Charles E Garlock Date 9/24/93
Surveyor's Michigan License No. 14762

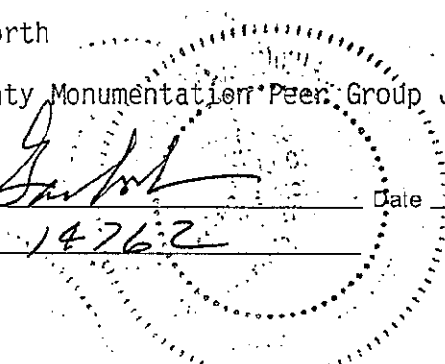

10/26/93

"Be Sure of Your Ground"

CHARLES E. GARLOCK
PROFESSIONAL SURVEYOR
840 EAST DAVIS ROAD
HOWELL, MICHIGAN 48843
OFFICE: (517) 546-3340
FAX: 517 546-2941


July 12, 1993

L-13: South 1/4 corner Section 36 Handy Twp. Liv. Co. MI

Corner set by L Munsell in 1968 in line with fence line to North and a split of road side fences, point falling on centerline of E-W road and is within 0.78 ft. of split between SW and SE corner of Section 36. Sweep of area found no additional corners and appears to have been no other surveys in area the past 100 years.; except in NE 1/4 and NW 1/4 Section 1 Iosco Twp. and these surveys were tied to the Howell Twp. corners.



Charles E Garlock, PS

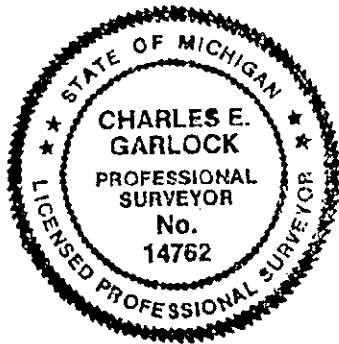

Found PK spike in Asphalt road

SUCCESSOR TO:

- MILES W. BULLOCK, L.S. (1844 TO 1926) ● GRANT H DUNNING, P.E. (1865 TO 1928)
- CLAY W. GORDON, RLS (1883 TO 1970) ● LYLE W. MUNSELL, RLS (1904 TO 1987)

SM, SE, A-13, 3