

1993

COMMISSION

LAND CORNER RECORDATION CERTIFICATE
Filing Requirement of Act 74, Mich. P.A. 1970

FILED

22 9 29 AM '93
NANCY HAVILAND
REGISTER OF DEEDS
LIVINGSTON COUNTY, MI
48843

For corners in

LIVINGSTON
(County)

Located In:

Corner Code #

- 1. Public Land Survey T 3N R 3E M-1
- T _____ R _____
- T _____ R _____
- T _____ R _____
- 2. Property Controlling S _____ T _____ R _____
- in Section S _____ T _____ R _____
- 3. Miscellaneous S _____ T _____ R _____
- Property in Sec. S _____ T _____ R _____

L.S.C. # 78m

Register of Deeds Stamp & File Number

- 4. Lot No. _____, Recorded Plat _____
- 5. Private Claims _____

A	B	C	D	E	F	G	H	I	J	K	L	M
2	6	5	4	3	2	1						
3												
4	7	8	9	10	11	12						
5												
6	18	17	16	15	14	13						
7												
8	19	20	21	22	23	24						
9												
10	30	29	28	27	26	25						
11												
12	31	32	33	34	35	36						
13												

I, DONALD G. RICHARDS, in a field survey on October 19, 19 93, do hereby certify that under requirements of P.A. 74, Michigan P.A. of 1970, the corner points mentioned in lines 1 and 2 above were in conformance with regulations and rules therefore as required in the current manual of survey instructions of the United States Department of the Interior, Bureau of Land Management or by a decree of a Court of Law and/or that the corner points mentioned in lines 3, 4 and 5 above were in conformance with the rules of the Michigan Board of Land Surveyors or by a Decree of a Court of Law; established, re-established, monumented, re-monumented, recovered, found as expressed below:

NOTE: Not more than 4 corners, all in the same town and range, may be recorded on this certificate.

A. Description of original monument and accessories and/or subsequent restoration:


April 15th, 1823
"Intersected West Boundary 4.60 South of Temporary Post, Set Post at intersection
White Oak 10 N 84 W 44
White Oak 12 N 56 1/2 E 51"

B. Description of corner evidence found and/or method applied in restoring or reestablishing corner:

Found Iron Rod with cap No. 12024

C. Description of monument for corner and accessories established to perpetuate locating the position of the corner:

Re-set with 1 1/4" x 36" iron pipe w/brass cap stamped "Livingston Michigan
County Remonumentation Corner" in Monument Box
S 75 W 112.68' nail/LCWT* in N face 26" Maple
N 45 W 57.78' nail/LCWT in SW face twin 10" Ash
N 45 E 65.94' nail/LCWT in SE face 8" Walnut
S 45 E 43.57' nail/LCWT in NE face 27" Maple
(* Livingston County Witness Tag)

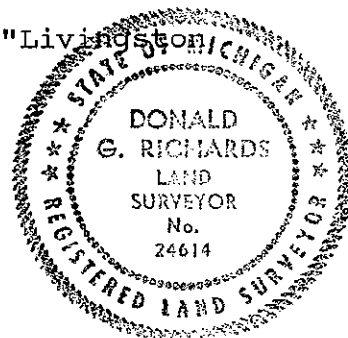

Signed by DONALD G. RICHARDS *[Signature]*

Date December 10, 1993

Surveyor's Michigan License No. 24614
Corner M-13, T4N-R3E APPROVED by Livingston County Monumentation
Peer Group 11-10-93