

LAND CORNER RECORDATION CERTIFICATE
Filing Requirement of Act 74, Mich. P.A. 1970

For corners in
Livingston
(County)
Located In: Corner Code #
1. Public Land Survey T 3NR 3E M-2
T R
T R
T R
2. Property Controlling S T R
in Section S T R
3. Miscellaneous S T R
Property in Sec. S T R

FILED
AUG 27 10 26 AM '96
NANCY HAVILAND
REGISTER OF DEEDS
LIVINGSTON COUNTY, MI
48843
L.S.C. #550m
Register of Deeds Stamp & File Number

4. Lot No. _____, Recorded Plat _____
5. Private Claims _____

	A	B	C	D	E	F	G	H	I	J	K	L	M
1													
2	6		5		4		3		2		1		
3													
4	7		8		9		10		11		12		
5													
6	18		17		16		15		14		13		
7													
8	19		20		21		22		23		24		
9													
10	30		29		28		27		26		25		
11													
12	31		32		33		34		35		36		
13													


I, Charles E Garlock, in a field survey on August 20, 1996 do hereby state that under requirements of P.A. 74, Michigan P.A. of 1970, the corner points mentioned in lines 1 and 2 above were in conformance with regulations and rules therefore as required in the current manual of survey instructions of the United States Department of the Interior, Bureau of Land Management or by a decree of a Court of Law and/or that the corner points mentioned in lines 3, 4 and 5 above were in conformance with the rules of the Michigan Board of Land Surveyors or by a Decree of a Court of Law; established, re-established, monumented, recovered, found as expressed below:

NOTE: Not more than 2 corners, all in the same town and range, may be recorded on this certificate.

A. Description of original monument and accessories and/or subsequent restoration:
GLO survey dated: April 15, 1825 by S Sibley, DS
GLO witnesses: Tam 14-S4W-54 lks
Tam 16-N12W-20 Lks

Additional historical data on rear of sheet

B. Description of corner evidence found and/or method applied in restoring or reestablishing corner:
Found 5/8" I. rod, 2.5' West of C/L Asphalt and hedge row to West.

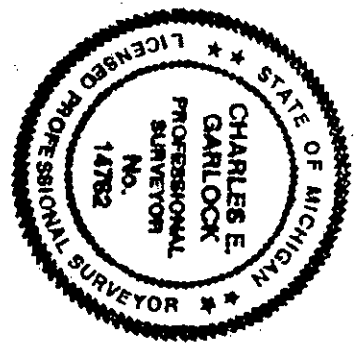

C. Description of monument for corner and accessories established to perpetuate locating the position of the corner:
M-2: E 1/4 cor. Sec. 1 T3N-R3E, Handy Twp. Liv. Co.MI. Set Mon Box and 1 1/4" X 36" I. Pipe with 6" breakaway top and with Liv. Co.Remon brass cap on top.
N80W-33.34'-sp & tag N/s 20" Oak
N30W-49.03'-c/l 4" Steel post (Michcon sign on top)
S15E-73.80'-sp & tag W/s 10" Box Elder
S10W-111.18'-sp & tag E/s 10" Willow
East-2.5'±± c/l Owosso Road
North-65'±± c/l Driveway to Hse #5533

P.A. 345 1980, APPROVED BY LIVINGSTON COUNTY
PEER GROUP ON 3/27/96, CO. REP JED

Signed by Charles E Garlock
Surveyor's Michigan License No. 14762


Date August 21, 1996

CORNER SUMMARY

M-2: EAST 1/4 CORNER SECTION 1, T3N-R3E, ~~HANDY TOWNSHIP~~ ~~CO MICH~~
LIVINGSTON COUNTY, MICHIGAN.

GLO SURVEY DATED APRIL 15, 1825 BY S SIBLEY, DS, AND NONE OF THE
GLO WITNESSES REMAIN.

J ALBRIGHT FOUND/SET A 5/8" I. ROD IN 1970, WE FOUND TWO OF HIS
WITNESSES AND THEY CHECK. IN SUBSEQUENT SURVEYS BY VERBA-1973,
BOSS-1974, 1977 & 1992, CHMP-1991, HUGHES-1988 AND MYSELF-1994, WE
FOUND ONE OR ALL OF EACH SURVEYORS WITNESSES AND THEY CHECK TO THE
5/8" I. ROD. MEASURED NORTH 198.92 FEET TO THE W 1/4 CORNER OF
SECTION 6 HOWELL TWP. FOUND TWO ACT 74'S RECORDED AND THREE ACT
132'S. CORNER IS ABOUT 2.5 FEET WEST OF THE ASPHALT CENTERLINE OF
OWOSSO ROAD AND INLINE WITH A HEDGE ROW TO THE WEST. MEASURES
NORTH ARE 2330.81 BY VERBA, 2330.88 BY CHMP, 2330.71 BY BOSS AND
2329.74 BY NEWMAN. MEASURES SOUTH ARE 2637.09 BY VERBA, 2636.74 BY
HUGHES & MYSELF AND 2626.70 BY NEWMAN. MEASURES WEST ARE 2627.51
BY BOSS, 2628.71 BY VERBA AND 2626.50 BY NEWMAN. VERBA STATED
CORNER WAS SET ON LINE AT RECORD PRORATION, WHICH IS WITHIN 3
FEET±. CORNER NOT SUITABLE FOR GPS. RECOMMEND CONTINUED USE OF
CORNER AS FOUND.


CHARLES E GARLOCK
PS 14762
HAN96M2

T3N3E
M-2