

LAND CORNER RECORDATION CERTIFICATE
Filing Requirement of Act 74, Mich. P.A. 1970

FILED

For corners in

Livingston
(County)

Located In:

Corner Code #

- 1. Public Land Survey T 3N R 3E M-3
 T R
 T R
 T R
- 2. Property Controlling S T R
 in Section S T R
- 3. Miscellaneous S T R
 Property in Sec. S T R

AUG 27 10 26 AM '96
NANCY HAVILAND
REGISTER OF DEEDS
LIVINGSTON COUNTY, MI.
48843

L.S.C.#549m

Register of Deeds Stamp & File Number

- 4. Lot No. _____, Recorded Plat _____
- 5. Private Claims _____

I, Charles E Garlock, in a field survey on August 20, 19 96 do hereby state that under requirements of P.A. 74, Michigan P.A. of 1970, the corner points mentioned in lines 1 and 2 above were in conformance with regulations and rules therefore as required in the current manual of survey instructions of the United States Department of the Interior, Bureau of Land Management or by a decree of a Court of Law and /or that the corner points mentioned in lines 3, 4 and 5 above were in conformance with the rules of the Michigan Board of Land Surveyors or by a Decree of a Court of Law; established, re-established, monumented, recovered, found as expressed below:


NOTE: Not more than 2 corners, all in the same town and range, may be recorded on this certificate.

A	B	C	D	E	F	G	H	I	J	K	L	M
1												
2	6		5		4		3		2		1	
3												
4	7		8		9		10		11		12	
5												
6	18		17		16		15		14		13	
7												
8	19		20		21		22		23		24	
9												
10	30		29		28		27		26		25	
11												
12	31		32		33		34		35		36	
13												

- A. Description of original monument and accessories and/or subsequent restoration:
 GLO survey dated April 15, 1824 by S Sibley, DS
 GLO witnesses: W09-S20W-27 lks
 W024-N43W-74 lks

Additional historical data on rear of sheet

- B. Description of corner evidence found and/or method applied in restoring or reestablishing corner:
 Found R.R. spike 2.5' East of c/l of Owosso Road. and inline with North edge of gravel of Sharpe Road to the West.

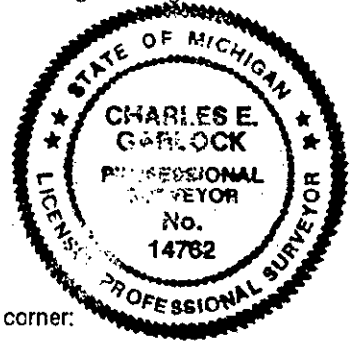

- C. Description of monument for corner and accessories established to perpetuate locating the position of the corner:
 M-3: SE cor. Sec. 1, T3N-R3E, Handy Twp. Liv. Co. MI. Set Mon Box with set 1 1/4" X 36" I. Pipe with 6" breakaway top and Liv. Co. Remon brass cap cemeted on top inside.
 166°-103.02'-sp & tag W/s 8: elm
 201°-79.40'-sp & tag W/s 8" Blue Spruce
 223°-75.76'-to NE cor. House #6005
 287°-62.18'-sp & tag N/s U Pole
 020°-123.84'-sp & tag E/s 48" Box Elder
 South-7'±-c/l Sharpe Road to the West.

RA. 345 1990, APPROVED BY LIVINGSTON COUNTY
PEER GROUP ON 3/27/96, CO. REP JED

Signed by Charles E Garlock
Surveyor's Michigan License No. 14762

Date August 21, 1996



CORNER SUMMARY

M-3: NORTHEAST CORNER OF SECTION 12, T3N-R3E, HANDY TOWNSHIP,
LIVINGSTON COUNTY, MICHIGAN.

GLO SURVEY DATED APRIL 15, 1825 BY S SIBLEY, DS, AND NONE OF THE
GLO WITNESSES REMAIN.

NO KNOWN ACTIVITY UNTIL 1970 WHEN J ALBRIGHT SURVEYED THE DETROIT
EDISON HIGHLINE RIGHT-OF-WAYS AND D VERBA SURVEYED A TRACT FOR
MICHIGAN CONSOLIDATED GAS CO., THEIR WITNESSES WERE THE SAME AND
TWO REMAINING WITNESSES CHECK TO A RR SPIKE. BOTH RECORDED ACT
74'S. REMAINING WITNESSES BY BENTON, BOSS, HUGHES AND MYSELF ALSO
CHECK. FOUND A RR SPIKE 195.77 FEET NORTH FOR THE SOUTHWEST
CORNER OF SECTION 6 HOWELL TWP. THE NORTHEAST CORNER OF SECTION
12 IS A RR SPIKE ABOUT 2 FOOT EAST OF THE CENTERLINE OF OWOSSO
ROAD AND LINES WITH THE NORTH GRAVEL EDGE OF SHARPE ROAD TO THE
WEST. MEASURES NORTH ARE: 2637.09 BY VERBA, 2636.74 BY HUGHES
AND MYSELF AND 2626.70 BY NEWMAN. MEASURES WEST ARE 2639.36 BY
ALBRIGHT AND BOSS, 2639.86 BY VERBA, 2639.45 BY HUGHES, 2639.62 BY
BENTON AND 2638.85 BY NEWMAN. MEASURE SOUTH 2665.30 BY MYSELF.
FOUND TWO ACT 74'S AND THREE ACT 132'S RECORDED. CORNER IS IN THE
ASPHALT SURFACE OF OWOSSO ROAD AND IS SUITABLE FOR GPS. RECOMMEND
THE CONTINUED USE OF THE CORNER AS FOUND AND RESET WITH STANDARD
REMON. PIPE AND MON. BOX.

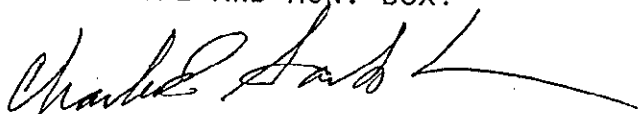

CHARLES E GARLOCK
PS 14762
HAN96M3

M3E

M3