

**SURVEY &
REMONUMENTATION**

FILED

α

JUN 29 1995

LAND CORNER RECORDATION CERTIFICATE
Filing Requirement of Act 74, Mich. P.A. 1970

APR 26 9 04 AM '95

For corners in **COMMISSION**

NANCY HAVILAND
REGISTER OF DEEDS
LIVINGSTON COUNTY, MI
48843

Livingston
(County)

Located In:

Corner Code ##

- | | | |
|------------------------------------|-------------------------|------------|
| 1. Public Land Survey | T <u>3N</u> R <u>3E</u> | <u>M-5</u> |
| | T _____ R _____ | _____ |
| | T _____ R _____ | _____ |
| | T _____ R _____ | _____ |
| 2. Property Controlling in Section | S _____ T _____ R _____ | _____ |
| | S _____ T _____ R _____ | _____ |
| 3. Miscellaneous Property in Sec. | S _____ T _____ R _____ | _____ |
| | S _____ T _____ R _____ | _____ |

L.S.C. #390m

Register of Deeds Stamp & File Number

4. Lot No. _____, Recorded Plat _____
5. Private Claims _____

	A	B	C	D	E	F	G	H	I	J	K	L	M
2	6		5		4		3		2		1		
3													
4	7		8		9		10		11		12		
5													
6	18		17		16		15		14		13		
7													
8	19		20		21		22		23		24		
9													
10	30		29		28		27		26		25		
11													
12	31		32		33		34		35		36		
13													


I, Charles E. Garlock, in a field survey on March 3, 1995, do hereby certify that under requirements of P.A. 74, Michigan P.A. of 1970, the corner points mentioned in lines 1 and 2 above were in conformance with regulations and rules therefore as required in the current manual of survey instructions of the United States Department of the Interior, Bureau of Land Management or by a decree of a Court of Law and/or that the corner points mentioned in lines 3, 4 and 5 above were in conformance with the rules of the Michigan Board of Land Surveyors or by a Decree of a Court of Law; established, re-established, monumented, re-monumented, recovered, found as expressed below:

NOTE: Not more than 4 corners, all in the same town and range, may be recorded on this certificate.

- A. Description of original monument and accessories and/or subsequent restoration:
GLO survey dated: April 15, 1825 by S Sibley
GLO Witnesses: Willow 12"-S86W-2
Ash 6"-S89W-20

Additional history of corner on reverse of sheet.

- B. Description of corner evidence found and/or method applied in restoring or reestablishing corner:
Found Boat spike in North-South fence line 154.8'± South of NW cor. Sec. 18 T3N-R4E

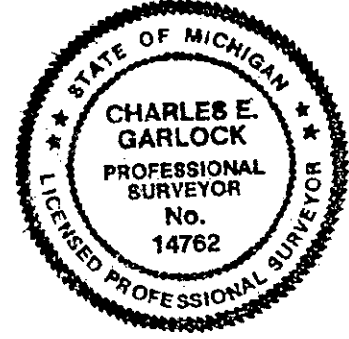

- C. Description of monument for corner and accessories established to perpetuate locating the position of the corner:
M-5: NE corner Section 13 T3N-R3E, Handy Twp. Liv. Co. MI, Set 1 1/4" X 36" I. Pipe with Liv. Co. Remon. brass cap on top.
S15W-107.65'-sp & tag E/side 27" Walnut
North-154.76'-ctr. wood corner post and 3/4" I. Pipe, NW cor. Sec. 18, T3N-R4E
N15E-168.01'-sp & tag E/s 14" Walnut
North-35.70'-sp & tag E/s 5" Elm
N35E-194.12'-sp & tag E/s 18" Hickory

P.A. 345 1990, APPROVED BY LIVINGSTON COUNTY PEER GROUP ON 3/1/95, CO. REPEALED

Signed by Charles E. Garlock

Date March 28, 1995

Surveyor's Michigan License No. 14762

CORNER SUMMARY

M-5: GLO SURVEY DATED APRIL 15, 1825 BY S SIBLEY, NONE OF THE GLO WITNESSES REMAIN.

NEXT KNOWN ACTIVITY WAS 1937 WHEN MSHD FOUND A POINTED STONE AND MEASURED THE GLO DISTANCE NORTH OF 155.76 FEET TO A 3/4" I. PIPE AT THE NW CORNER OF SECTION 18 HOWELL TWP. IN 1958 L MUNSELL FOUND THE POINTED STONE AND HIS WITNESSES WERE THE SAME AS MSHD. 1970 J ALBRIGHT FOUND A 1/2" I. ROD AND ONE OF HIS WITNESSES CHECKED WITH MSHD AND MUNSELL AS DID HIS MEASURE NORTH TO THE HOWELL CORNER. 1986 P BENTON FOUND A BOAT SPIKE FOR THE CORNER AND HIS MEASURE NORTH TO THE HOWELL CORNER CHECKED AS DID ONE WITNESS. WE FOUND THE BOAT SPIKE IN A NORTH-SOUTH FENCE LINE, THE MEASURE NORTH TO THE HOWELL CORNER CHECKED AS DID THE REMAINING WITNESSES OF PREVIOUS SURVEYORS. DETROIT EDISON MEASURED WEST 2636.36, BENTON CALCULATED 2635.48 AND AN OLD COUNTY SURVEYOR'S MEASURE BY BULLOCK WAS 2617.05 FEET; DETROIT EDISON HAD 2655.23 SOUTH. FOUND ONE ACT 74 RECORDED IN 1970 BY J ALBRIGHT AND ONE ACT 132 RECORDED. SITE IS A GOOD GPS POINT.

Charles E. Garlock

CHARLES E GARLOCK
PS14762

M5HAN95



EN-3E M-5

EN 20

