

JUN 29 1995

COMMISSION

LAND CORNER RECORDATION CERTIFICATE
 Filing Requirement of Act 74, Mich. P.A. 1970

APR 26 9 44 AM '95

NANCY HAVILAND
 REGISTER OF DEEDS
 LIVINGSTON COUNTY, MI
 48843

For corners in

<u>Livingston</u> <small>(County)</small>	Located In:	Corner Code <u>M-6</u>
1. Public Land Survey	T <u>3N</u> R <u>3E</u>	<u>M-6</u>
	T _____ R _____	_____
	T _____ R _____	_____
	T _____ R _____	_____
2. Property Controlling in Section	S _____ T _____ R _____	_____
	S _____ T _____ R _____	_____
3. Miscellaneous Property in Sec.	S _____ T _____ R _____	_____
	S _____ T _____ R _____	_____
4. Lot No. _____, Recorded Plat _____		
5. Private Claims _____		

L.S.C. #391m
 Register of Deeds Stamp & File Number

	A	B	C	D	E	F	G	H	I	J	K	L	M
2	6	5	4	3	2	1							
3													
4	7	8	9	10	11	12							
5													
6	18	17	16	15	14	13							
7													
8	19	20	21	22	23	24							
9													
10	30	29	28	27	26	25							
11													
12	31	32	33	34	35	36							
13													


I, Charles E. Garlock, in a field survey on March 3, 1995, do hereby certify that under requirements of P.A. 74, Michigan P.A. of 1970, the corner points mentioned in lines 1 and 2 above were in conformance with regulations and rules therefore as required in the current manual of survey instructions of the United States Department of the Interior, Bureau of Land Management or by a decree of a Court of Law and/or that the corner points mentioned in lines 3, 4 and 5 above were in conformance with the rules of the Michigan Board of Land Surveyors or by a Decree of a Court of Law; established, re-established, monumented, re-monumented, recovered, found as expressed below:

NOTE: Not more than 4 corners, all in the same town and range, may be recorded on this certificate.

A. Description of original monument and accessories and/or subsequent restoration:
 GLO survey dated: April 15, 1825 by S. Sibley
 GLO Witnesses: R022-S3W-22
 Sym-N70W-18

Additional history of corner on reverse of sheet.

B. Description of corner evidence found and/or method applied in restoring or reestablishing corner:
 Found 1 1/2" X 30" I. Pipe in center of Old corner post hole rung with stones and with fences line North, South and West.

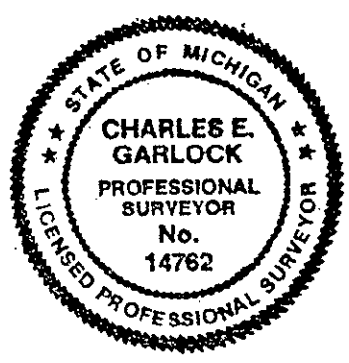

C. Description of monument for corner and accessories established to perpetuate locating the position of the corner:
 M-6: East 1/4 corner Section 13, T3N-R3E, Handy Twp. Liv. Co. MI; saved found I. Pipe and set Liv. Co. Remon. brass cap on top.
 S15W-23.96'-sp & tag W/s 4" Ash
 S50W-17.52'-sp & tag-S/s 8" maple
 S85W-9.13'-sp & tag N/s 10" Ash
 N25W-30.70'-sp & tag W/s 18" Ash
 North-14.38'-sp & tag W/s 12" Cherry
 North-138.51'-1/2" I. rod W/s of wood corner post, W 1/4 cor. Sec. 18, T3N-R4E
 Howell Twp. Liv.Co. MI

PA. 345 1990, APPROVED BY LIVINGSTON COU
 PEER GROUP ON 3/1/95, CO. REP LED

Signed by Charles E. Garlock Date March 28, 1995
 Surveyor's Michigan License No. 14762


CORNER SUMMARY

M-6: GLO SURVEY DATED APRIL 15, 1825 BY S SIBLEY, NONE OF THE GLO WITNESSES REMAIN.

EARLIEST KNOWN ACTIVITY WAS IN 1970 BY J ALBRIGHT WHEN HE FOUND A 1/2" I. ROD IN CENTER OF A POST HOLE RUNG WITH STONES WITH FENCE LINES NORTH-SOUTH AND WEST; ONE WITNESS REMAINS AND IT CHECKS. L BRYAN IN 1991 FOUND OR SET A 1 1/2" I. PIPE IN THE CENTER OF SAID CORNER POST HOLE WITH VERY OLD FENCES NORTH-SOUTH AND WEST, 3 OF HIS WITNESSES REMAIN AND THEY CHECK, ONE OF WHICH CHECKS WITH J ALBRIGHTS. MEASURES WEST TO THE CENTER OF SECTION ARE: 2605.52 BY DETROIT EDISON, 2605.54 BY ALBRIGHT AND 2604.72 BY BRYAN; NORTH 2655.23 BY DETROIT EDISON AND SOUTH 2637.18 BY L BRYAN. JOHN ALBRIGHT RECORDED AN ACT 74 FOR THE CORNER BUT FOUND NO ACT 132'S RECORDED. IT APPEARS THAT ALL HAVE USED EXISTING OCCUPATION AS THE 1/4 CORNER. AREA IS WOODED TO THE WEST AND OVERHANGING TREES TO THE EAST, MAKING THIS A POOR GPS POINT.

CHARLES E. GARLOCK
PS14762

M6HAN95

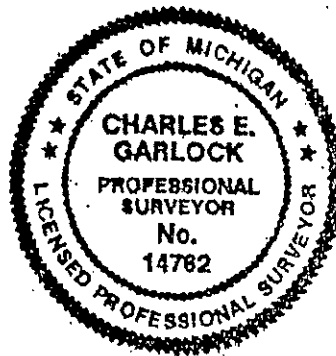

3V-3E
1116