

FILED

AUG 9 3 43 PM '94

LAND CORNER RECORDATION CERTIFICATE
Filing Requirement of Act 74, Mich. P.A. 1970

NANCY HAVILAND
REGISTER OF DEEDS
LIVINGSTON COUNTY, MI
48843

For corners in

Livingston
(County)

Located In:

Corner Code #

- 1. Public Land Survey T 3N R 3E M-9
 T _____ R _____
 T _____ R _____
 T _____ R _____
- 2. Property Controlling S _____ T _____ R _____
 in Section S _____ T _____ R _____
- 3. Miscellaneous S _____ T _____ R _____
 Property in Sec. S _____ T _____ R _____

L.S.C.#211m

Register of Deeds Stamp & File Number

- 4. Lot No. _____, Recorded Plat _____
- 5. Private Claims _____

	A	B	C	D	E	F	G	H	I	J	K	L	M
2	6	5	4	3	2	1							
3													
4	7	8	9	10	11	12							
5													
6	18	17	16	15	14	13							
7													
8	19	20	21	22	23	24							
9													
10	30	29	28	27	26	25							
11													
12	31	32	33	34	35	36							
13													

I, Charles E Garlock, in a field survey on August 5, 19 94, do hereby certify that under requirements of P.A. 74, Michigan P.A. of 1970, the corner points mentioned in lines 1 and 2 above were in conformance with regulations and rules therefore as required in the current manual of survey instructions of the United States Department of the Interior, Bureau of Land Management or by a decree of a Court of Law and/or that the corner points mentioned in lines 3, 4 and 5 above were in conformance with the rules of the Michigan Board of Land Surveyors or by a Decree of a Court of Law; established, re-established, monumented, re-monumented, recovered, found as expressed below:

NOTE: Not more than 4 corners, all in the same town and range, may be recorded on this certificate.


- A. Description of original monument and accessories and/or subsequent restoration:
 GLO survey date: April 15, 1825
 GLO witnessess: W020-N27W-0.13 ch
 W0 14-S30W-0.27 ch

See additional data on rear of sheet

- B. Description of corner evidence found and/or method applied in restoring or reestablishing corner:
 Found 1/2" I. rod, as per D Hughes survey

SURVEY &
REMONUMENTATION
SEP 26 1994
COMMISSION

- C. Description of monument for corner and accessories established to perpetuate locating the position of the corner:
 M-9: SE cor. Sec. 24, T3N-R3E, Handy Twp. Liv. Co. MI., set 1 1/4" X 36" I. Pipe with Liv.Co. Remon brass cap on top (+0.4')
 N10E-10.51'-sp & tag E/s 20" maple
 N20W-11.47'-sp & tag E/s 14" Oak
 S10W-16.60'-sp & tag E/s 20" Cherry
 S45E-20.79'-sp & tag W/s 18" Oak
 West-15.25'-fence running N-S

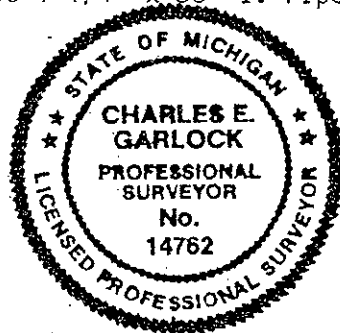

Signed by Charles E Garlock Date August 6, 1994

Surveyor's Michigan License No. 14762

CORNER SUMMARY

M-9: NORTHEAST CORNER OF SECTION 25, T3N-R3E, HANDY TOWNSHIP, LIVINGSTON COUNTY, MICHIGAN.

GLO SURVEY DATED APRIL 15, 1825 BY S. SIBLEY AND FOUND NONE OF THE GLO WITNESSES REMAIN.

M. BULLOCK HAD BEEN TO THE CORNER AT AN UNKNOWN DATE (1900±) AND MEASURED WEST 2616.24 FEET TO THE NORTH 1/4 CORNER, GLO CALLED FOR 2630.76 FEET AND BOSS ENGR. HAD 2628.56 IN RECENT YEARS. THE CORNER WAS SET BY D HUGHES IN 1983 AT THE GLO JOG OF 73.26 FEET SOUTH OF THE NORTHWEST CORNER OF SECTION 19 HOWELL TOWNSHIP AND 2628.56 FEET EAST OF THE NORTH 1/4 CORNER (AS PER BOSS ENGR). THE CORNER FELL ABOUT 10 FEET EAST OF AN OLD NORTH-SOUTH FENCE LINE AS DID THE NORTHWEST CORNER OF SECTION 19 HOWELL TOWNSHIP, BUT THE HOWELL CORNER WAS IN AN OLD FENCE LINE RUNNING TO THE EAST. FOUND NO OTHER IRONS IN THE AREA AND NO OCCUPATION LINES TO THE WEST OF THE NORTHEAST SECTION CORNER. NO ACT 74'S RECORDED AND ONLY 2 ACT 132'S RECORDED. FOUND IN COMPARING THE DISTANCES ALONG THE TOWNSHIP LINE THE FOLLOWING: EAST LINE OF SECTION 25 MEASURES 5264.23 AND THE EAST LINE OF SECTION 24 MEASURES 5279.44, NOT TOO BAD.

