

SURVEY & REMONUMENTATION

OCT 25 1993

COMMISSION

LAND CORNER RECORDATION CERTIFICATE
Filing Requirement of Act 74, Mich. P.A. 1970

FILED
 AUG 26 9 13 AM '93
 NANCY HAVILAND
 REGISTER OF DEEDS
 LIVINGSTON COUNTY, MI
 48863

For corners in Livingston (County) Located In: Corner Code ##

1. Public Land Survey	T <u>3N</u> R <u>3E</u>	<u>M-11</u>
	T _____ R _____	_____
	T _____ R _____	_____
	T _____ R _____	_____
2. Property Controlling in Section	S _____ T _____ R _____	_____
	S _____ T _____ R _____	_____
3. Miscellaneous Property in Sec.	S _____ T _____ R _____	_____
	S _____ T _____ R _____	_____
4. Lot No. _____, Recorded Plat _____		
5. Private Claims _____		

6 m
L.S.C.#
Register of Deeds Stamp & File Number

	A	B	C	D	E	F	G	H	I	J	K	L	M
2	6		5		4		3		2		1		
3													
4	7		8		9		10		11		12		
5													
6	18		17		16		15		14		13		
7													
8	19		20		21		22		23		24		
9													
10	30		29		28		27		26		25		
11													
12	31		32		33		34		35		36		
13													

I, Charles E Garlock, in a field survey on August 24, 19 93, do hereby certify that under requirements of P.A. 74, Michigan P.A. of 1970, the corner points mentioned in lines 1 and 2 above were in conformance with regulations and rules therefore as required in the current manual of survey instructions of the United States Department of the Interior, Bureau of Land Management or by a decree of a Court of Law and/or that the corner points mentioned in lines 3, 4 and 5 above were in conformance with the rules of the Michigan Board of Land Surveyors or by a Decree of a Court of Law; established, re-established, monumented, re-monumented, recovered, found as expressed below:

NOTE: Not more than 4 corners, all in the same town and range, may be recorded on this certificate.

A. Description of original monument and accessories and/or subsequent restoration:

GLO notes: WO 24-S17W-107 lks
Aspin 14-N68W-55 lks
County Surveyor notes: WO 22-N45-10W-66Lks (1878±)
W Ash 14-S17W-9½ lks.
See additional notes on back of this sheet:

GLO notes April 15, 1825, S Sibley

B. Description of corner evidence found and/or method applied in restoring or reestablishing corner:

Found Railroad spike

C. Description of monument for corner and accessories established to perpetuate locating the position of the corner:

Set 1 1/4" X 30" I. Pipe raised with 1 1/4" X 6" I. Pipe with brass cap marked: Liv. Co. Mon. Cor. at (-0.5')

S45W-29.20'-spike SE/side 40" W Oak
N45W-45.09'-sp NE/side 48" W Oak (66 lks to nearest face in 1878)
S30E-49.84'-spike W/side 15' Maple
S20W-79.26'-spike E/side 28" oak
North-10'±-centerline Road to West and on centerline of North-South Road

Approved by Liv. Co. Mon. Peer Group, July 21, 1993

Signed by *Charles E Garlock* Date August 25, 1993
Surveyor's Michigan License No. 14762

10/26/93

"Be Sure of Your Ground"

CHARLES E. GARLOCK
PROFESSIONAL SURVEYOR
840 EAST DAVIS ROAD
HOWELL, MICHIGAN 48843
OFFICE: (517) 546-3340
FAX: 517 546-2941


July 12, 1993

M - 11: NE cor. Sec. 36 Handy Twp. Liv. Co. MI

An 1878 witness by I Teller matches witnesses by Munsell-1964, Wilson-1972, Garlock-1981 and tree still exists today. A Railroad spike was found by Munsell, Wilson, Hughes and Garlock in earlier surveys (1964-1983) and is still present. Measure North to Howell Twp. Sec. corner is 43.95 ft. GLO=44.25 ft. Found no additional irons in a sweep of the area.



Charles E Garlock, PS

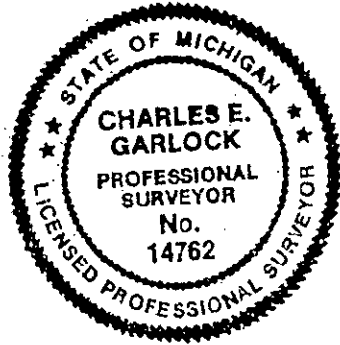

Found R. R. spike at (-0.5') on Gravel Road

SUCCESSOR TO:

MILES W. BULLOCK, L.S. (1844 TO 1926) ● GRANT H DUNNING, P.E. (1865 TO 1928)
CLAY W. GORDON, RLS (1883 TO 1970) ● LYLE W. MUNSELL, RLS (1904 TO 1987)