

**SURVEY &  
REMONUMENTATION**

OCT 25 1993

**COMMISSION**

**LAND CORNER RECORDATION CERTIFICATE**  
Filing Requirement of Act 74, Mich. P.A. 1970

**FILED**

SEP 27 8 38 AM '93

NANCY HAVILAND  
REGISTER OF DEEDS  
LIVINGSTON COUNTY, MI  
48843

For corners in

Livingston  
(County)

Located In:

Corner Code ##

- |                                    |   |           |   |           |             |
|------------------------------------|---|-----------|---|-----------|-------------|
| 1. Public Land Survey              | T | <u>3N</u> | R | <u>3E</u> | <u>M-12</u> |
|                                    | T | _____     | R | _____     | _____       |
|                                    | T | _____     | R | _____     | _____       |
|                                    | T | _____     | R | _____     | _____       |
| 2. Property Controlling in Section | S | _____     | T | _____     | R           |
|                                    | S | _____     | T | _____     | R           |
| 3. Miscellaneous Property in Sec.  | S | _____     | T | _____     | R           |
|                                    | S | _____     | T | _____     | R           |

L.S.C. #11m:

Register of Deeds Stamp & File Number

4. Lot No. \_\_\_\_\_, Recorded Plat \_\_\_\_\_  
5. Private Claims \_\_\_\_\_

	A	B	C	D	E	F	G	H	I	J	K	L	M
2	6	5	4	3	2	1							
3													
4	7	8	9	10	11	12							
5													
6	18	17	16	15	14	13							
7													
8	19	20	21	22	23	24							
9													
10	30	29	28	27	26	25							
11													
12	31	32	33	34	35	36							
13													

I, Charles E. Garlock, in a field survey on September 22, 1993, do hereby certify that under requirements of P.A. 74, Michigan P.A. of 1970, the corner points mentioned in lines 1 and 2 above were in conformance with regulations and rules therefore as required in the current manual of survey instructions of the United States Department of the Interior, Bureau of Land Management or by a decree of a Court of Law and/or that the corner points mentioned in lines 3, 4 and 5 above were in conformance with the rules of the Michigan Board of Land Surveyors or by a Decree of a Court of Law; established, re-established, monumented, re-monumented, recovered, found as expressed below:

NOTE: Not more than 4 corners, all in the same town and range, may be recorded on this certificate.

- A. Description of original monument and accessories and/or subsequent restoration:  
GLO witnesses to E 1/4 con. (M-12)  
S81 1/2E-2.58ch-14" Aspin; no other

See reverse side for corner summary of research


GLO notes dated: April 15, 1825, Sylvester Sibley

- B. Description of corner evidence found and/or method applied in restoring or reestablishing corner:  
Found 1/2" I. Rod from previous witnesses

- C. Description of monument for corner and accessories established to perpetuate locating the position of the corner:  
Re-set with 1 1/4" X 36" I. Pipe with Liv. Co. Monumentation cap at -0.5'  
East-4.5'±-ctr. Truhn Rd.  
North-3.5'±-fence line West  
North-22.0'-fence line East  
N45E-43.71'-Sp SE/s 6" maple  
N80W-33.42'-sp N/s Wood corner post  
S45E-41.62'-sp SW/s dbl 12" maple  
S30E-71.68'-Sp/s 3-8" Elms  
West-centerline of ditch ±

APPROVED by Livingston County  
Monumentation Peer Group  
July 21, 1993

Signed by Charles E. Garlock Date 9/23/93  
Surveyor's Michigan License No. 14762

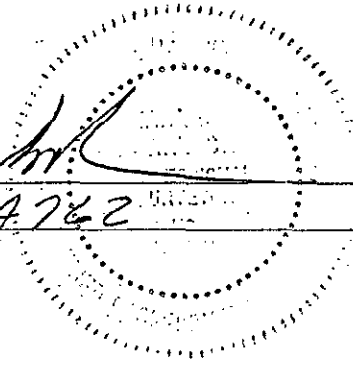

10/26/93

*"Be Sure of Your Ground"*

**CHARLES E. GARLOCK**  
PROFESSIONAL SURVEYOR  
840 EAST DAVIS ROAD  
HOWELL, MICHIGAN 48843  
OFFICE: (517) 546-3340  
FAX: 517 546-2941

July 12, 1993

M - 12: East 1/4 corner Sec. 36 Handy Twp. Liv. Co. MI

Found iron within 0.13 ft. split of distances between NE and SE Section corners with a deflection of  $0^{\circ}00'13''$ . Found 1/4 corner for Howell Twp. 22 ft North, which is 1/2 distance of 43.95 ft. jog at the NE corner of section 36. Pre-1900 witnesses trees not present. Sweep for additional corner hampered by CMP crossing Road several feet Southerly. The found iron lines with the North edge of a drainage ditch to the West. Found note in Old County survey records, "E 1/4 corner established 1.05 ch. South of Bullock's E 1/4 corner" Searched area 66 ft. plus, North and South of found iron and found nothing.



Charles E Garlock, PS



Found 1/2" I. Rod in Gravel Road at (-1.0')

SUCCESSOR TO:

MILES W. BULLOCK, L.S. (1844 TO 1926) ● GRANT H DUNNING, P.E. (1865 TO 1926)  
CLAY W. GORDON, RLS (1883 TO 1970) ● LYLE W. MUNSELL, RLS (1904 TO 1987)