

**LAND CORNER RECORDATION CERTIFICATE**  
 Filing Requirement of Act 74, Mich. P.A. 1970

AUG 22 9 51 AM '95  
 HANCOCK HAVILLAND  
 REGISTER OF DEEDS  
 LIVINGSTON COUNTY, MI  
 48843

9-  
 FILED

For corners in Livingston (County)

Located In: Corner Code #/

1. Public Land Survey	T <u>3N</u> R <u>4E</u>	<u>A-11</u>
	T _____ R _____	_____
	T _____ R _____	_____
	T _____ R _____	_____
2. Property Controlling in Section	S _____ T _____ R _____	_____
	S _____ T _____ R _____	_____
3. Miscellaneous Property in Sec.	S _____ T _____ R _____	_____
	S _____ T _____ R _____	_____

L. S. C. #422m  
 Register of Deeds Stamp & File Number

4. Lot No. \_\_\_\_\_, Recorded Plat \_\_\_\_\_

5. Private Claims \_\_\_\_\_

	A	B	C	D	E	F	G	H	I	J	K	L	M
2	6	5	4	3	2	1							
3													
4	7	8	9	10	11	12							
5													
6	18	17	16	15	14	13							
7													
8	19	20	21	22	23	24							
9													
10	30	29	28	27	26	25							
11													
12	31	32	33	34	35	36							
13													

Charles E Garlock, in a field survey on August 15, 19 95,  
 do hereby certify that under requirements of P.A. 74, Michigan P.A. of 1970, the corner points mentioned in lines 1 and 2 above were in conformance with regulations and rules therefore as required in the current manual of survey instructions of the United States Department of the Interior, Bureau of Land Management or by a decree of a Court of Law and/or that the corner points mentioned in lines 3, 4 and 5 above were in conformance with the rules of the Michigan Board of Land Surveyors or by a Decree of a Court of Law; established, re-established, monumented, re-monumented, recovered, found as expressed below:

**NOTE: Not more than 4 corners, all in the same town and range, may be recorded on this certificate.**


A. Description of original monument and accessories and/or subsequent restoration:  
 GLO survey date: April 15, 1825 by S Sibley, DS  
 GLO witnesses: WO-8-N57½E-10 lks  
 Aspen 15-S22½E-83 lks

Additional historical data on rear of sheet

B. Description of corner evidence found and/or method applied in restoring or reestablishing corner:  
 Found 5/8" I. Rod 0.10' West of Township line.

GURNEY'S  
 REMONUM  
 OCT 11 1855

C. Description of monument for corner and accessories established to perpetuate locating the position of the corner:  
 A-11: NW cor. Sec. 31, T3N-R4E, Howell Twp. Liv. Co. MI, set Amended cor. on Twp. line with 1 1/4" X 36" I. Pipe with breakaway top and Liv. Co. Remon brass cap on top at -0.5'  
 S80W-26.28'-sp & tag S/s 48" Oak  
 S25W-67.45'-sp & tag E/s 44" Oak  
 S40E-49.20'-sp & tag N/s 18" Maple  
 N35E-47.40'-sp & tag W/s 16" maple  
 West-1'±-c/l of Road  
 South-44.02'-NE cor. Sec. 36 T3N-R3E, Handy Twp.  
 Left found closing corner as found.

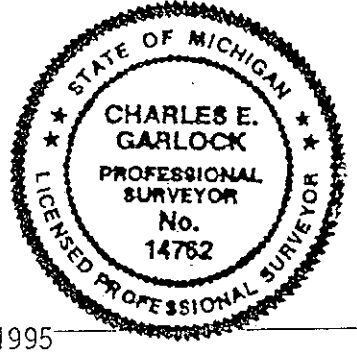

Signed by Charles E. Garlock Date August 15, 1995  
 Surveyor's Michigan License No. 14762


CORNER SUMMARY

A-11: NW COR. SEC. 31 T3N-R4E, HOWELL TWP. LIV. CO. MI

GLO SURVEY DATED APRIL 25, 1825 BY S SIBLEY, DS, AND NONE OF THE GLO WITNESSES REMAIN.

E GRANT WITNESSED THE CORNER IN 1877, SAME WITNESSES M BULLOCK HAD IN 1904, NONE REMAIN, BUT OLD COUNTY SURVEY NOTES SHOW THE MILE TO THE SOUTH SPLIT AT 2657.82 FT. C WILSON IN 1972 RECORDED AN ACT 74 TO A FOUND 1/2" I. ROD (SAME TODAY) AND HIS WITNESSES CHECK AS DO THOSE BY L MUNSELL IN 1964; LYLE ALSO MEASURED 44 FT. TO THE NE COR. SEC. 36 HANDY TWP. (44.02 FT. TODAY), WASH. ENGR. IN 1972, BENTON IN 1974, AND DESINE IN 1991, ZUHLKE MEASURED TO THE CORNER BUT WITNESSED NE COR. SEC. 36 HANDY TWP. (???). I FOUND SAID 1/2" I. ROD, 44.02 FT. NORTH OF THE HANDY SECTION CORNER AND 0.10 FT. WEST OF A LINE BETWEEN THE SE COR. AND E 1/4 COR OF SEC. 25 HANDY TWP. MEASURED SOUTH 2653.44 BY MYSELF AND 2653.60 BY ZUHLKE. POSSIBLE OCCUPATION TREE LINE TO THE EAST, BUT AREA IS DEVELOPED INTO SMALL ACREAGE PARCELS AND NO FENCES REMAIN. FOUR ACT 132'S RECORDED TO THIS CORNER. OVERHANGING TREES MAKE THIS A POOR GPS SITE ON THE GRAVEL TRUHN ROAD. SET AMENDED CORNER ON TOWNSHIP LINE.

CHARLES E GARLOCK  
PS 14762  
A11HOW95

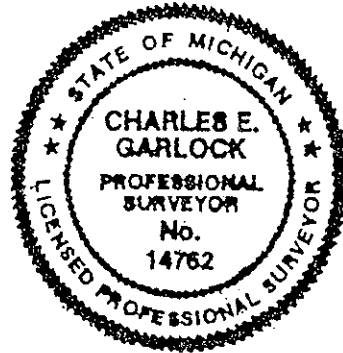

3N4E A11  
4