


CORNER SUMMARY


C-12: E 1/4 COR. SEC. 31 T3N-R4E, HOWELL TWP. LIV. CO. MI

GLO SURVEY DATED APRIL 15, 1825 BY S SIBLEY AND NONE OF THE GLO WITNESSES REMAIN.

E GRANT IN 1878 AND M BULLOCK IN 1898 WITNESSED SAID CORNER, BOTH WITNESSES ARE NOW GONE. C GORDON TIED TO THE CORNER IN 1931 AND ALL 6 OF HIS WITNESSES ARE GONE, BUT HE NOTED THE CORNER AS A WOOD CORNER POST WITH FENCE TO THE WEST. CHMP USED SAID CORNER POST IN 1979 AND WITNESSED IT TO TREES THAT BOSS ENGR CHECKED WITH IN A 1993 SURVEY, THE SAME WITNESSES I CHECKED WITH IN 1995. ALSO FINDING THE REMAINS OF AN OLD FENCE CORNER POST WITH FENCE LINES EAST, WEST AND SOUTH. MEASURED SOUTH 2656.54 FT. AND CHMP HAD 2656.25 FT. BOSS HAD 2662.34 FT. TO THE NORTH, THE SAME AS CHMP AND BOSS MEASURED 2654.86 FT. WEST. ONE ACT 132 RECORDED AND NO ACT 74'S RECORDED. CORNER IS LOCATED IN A WOODED AREA AND NOT A GOOD GPS SITE.



CHARLES E GARLOCK  
PS14762  
C12HOW95

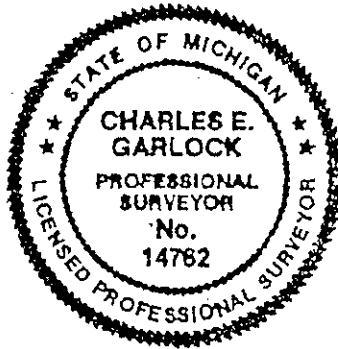

3N4E C12  
CP

