

LAND CORNER RECORDATION CERTIFICATE
Filing Requirement of Act 74, Mich. P.A. 1970

AUG 22 @ 51 AM '95
NANCY HAVILAND
REGISTER OF DEEDS
LIVINGSTON COUNTY, MI
48843

FILED

For corners in

Livingston
(County)

Located In:

Corner Code #/

- 1. Public Land Survey T 3N R 4E D-11
- T _____ R _____
- T _____ R _____
- T _____ R _____
- 2. Property Controlling S _____ T _____ R _____
- in Section S _____ T _____ R _____
- 3. Miscellaneous S _____ T _____ R _____
- Property in Sec. S _____ T _____ R _____

L. S. C. #426m

Register of Deeds Stamp & File Number

- 4. Lot No. _____, Recorded Plat _____
- 5. Private Claims _____

A	B	C	D	E	F	G	H	I	J	K	L	M
2	6	5	4	3	2	1						
3												
4	7	8	9	10	11	12						
5												
6	18	17	16	15	14	13						
7												
8	19	20	21	22	23	24						
9												
10	30	29	28	27	26	25						
11												
12	31	32	33	34	35	36						
13												

Charles E Garlock, in a field survey on June 22, 1995

do hereby certify that under requirements of P.A. 74, Michigan P.A. of 1970, the corner points mentioned in lines 1 and 2 above were in conformance with regulations and rules therefore as required in the current manual of survey instructions of the United States Department of the Interior, Bureau of Land Management or by a decree of a Court of Law and/or that the corner points mentioned in lines 3, 4 and 5 above were in conformance with the rules of the Michigan Board of Land Surveyors or by a Decree of a Court of Law, established, re-established, monumented, re-monumented, recovered, found as expressed below:

NOTE: Not more than 4 corners, all in the same town and range, may be recorded on this certificate.

- A. Description of original monument and accessories and/or subsequent restoration:
GLO survey dated April 15, 1825 by S Sibley, DS
GLO witnesses: Tam 5-N76E-9 lks
Tam 8-N88½W-17 lks

SURVEY & REMONUMENTATION


AUG 15 1995

Additional historical survey data on rear of sheet.

- B. Description of corner evidence found and/or method applied in restoring or reestablishing corner:
1/2" I. Rod cap #28414 gone, bulldozed out with recent activity together with fence line to the East and about 100' of fence to the West. Found iron about 75' to the North, laying on the ground, but found the remains of a guard fence post near the location (0.5'±) after the corner was reset per survey by CHMP job no. 20189. Agreed with found irons of this survey in other areas of the 1/4 section within 0.05'±. Setting at NE cor. Sec. 32, 0°00'00" South to E 1/4 cor. Sec. 32, 2649.32' meas. (rec. 2649.37') turned rec. angle right of 90°11'39" a record distance of 2645.72' to set N 1/4 corner of Sec. 32 as per CHMP survey.

- C. Description of monument for corner and accessories established to perpetuate locating the position of the corner:
D-11: N 1/4 cor. Sec. 32 T3N-R4E, Howell Twp. Liv. Co. MI, set 1 1/4" X 36" I. Pipe as per method described above with Liv. Co. Remon brass cap on top at -1.0'± with Carsonite guard post next to I. Pipe.

- Az 145°46'-141.24'-sp & tag SW/s 15" Poplar
- 191°30'-295.83'-sp & tag E/s 18" Hickory
- 205°36'-118.23'-top ctr. of 10" dia Steel casing
- 278°39'-166.03'-Sp & tag N/s 16" WicCherry
- 280°44'-188.33'-sp & tag N/s 24" Hickory
- 185°43'-71.18'-c/l top 4' dia CMP
- 170°40'-73.39'-c/l top 4' dia CMP

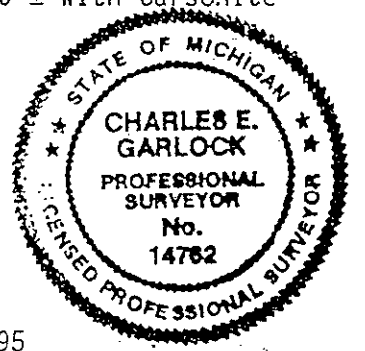

Signed by Charles E. Garlock

Date August 15, 1995

Surveyor's Michigan License No. 14762