

CORNER SUMMARY


D-11: NORTH 1/4 COR., SEC. 32, T3N-R4E, HOWELL TWP. LIV. CO. MI

GLO SURVEY DATED APRIL 15, 1825 BY S SIBLEY, DS, AND NONE OF THE GLO WITNESSES REMAIN.

EARLIEST KNOWN SURVEY ACTIVITY ARE WITNESSES BY E GRANT IN 1878. NEXT KNOWN ACTIVITY WAS 1974 WHEN STONEROCK USED A FOUND FENCE POST FOR THE CORNER AND FILED AN ACT 74, LATER DESCRIBED AS AN 1. ROD NEXT TO SAID POST. STONEROCK'S WITNESSES CHECKED WITH SURVEYS BY BOSS IN 1980 & 1993, NEWMAN IN 1990 AND WOLVERINE ENGR IN 1993. AT PRESENT I FOUND RECENT BULLDOZER ACTIVITY IN THE AREA OF THE N 1/4 COR. AND THE IRON WAS FOUND LAYING ON THE GROUND ABOUT 100 FT. N'LY. FENCE TO THE EAST WAS GONE, ABOUT 100 FT. OF FENCE TO THE WEST WAS GONE AND FOUND THE REMAINS OF A STEEL FENCE GUARD POST WITH PINK RIBBON, NO WITNESSES REMAINED. RESET THE N 1/4 COR. BY USING DATA BY CHMP, JOB NO. 20189. MEASURED WEST A RECORD DISTANCE OF 2645.22 FEET AND RECORD ANGLE FROM E 1/4 COR. THRU NE COR. TO N 1/4 COR. OF SEC. 32; THIS DISTANCE AGREED WITH SURVEYS BY STONEROCK AND BOSS ENGR. SAID RE-SET POINT FELL WITHIN 0.3 FT. OF THE FOUND STEEL FENCE GUARD POST WITH RIBBON AND IN LINE WITH THE REMAINS OF THE FENCE TO THE WEST. AREA IS IN AN OPEN FIELD AND A GOOD SPOT FOR A GPS STATION.

*Charles E. Garlock*

CHARLES E GARLOCK  
PS14762  
D11HOW95

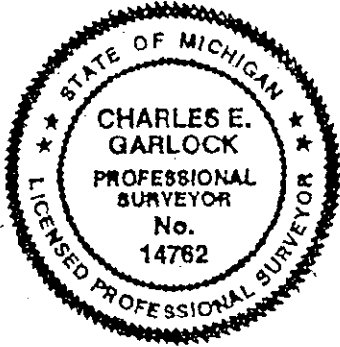

T3N-R4E D-11 4

OCT 26 1995

COMMISSION

LAND CORNER RECORDATION CERTIFICATE  
Filing Requirement of Act 74, Mich. P.A. 1970

FILED

OCT 3 - 10 15 AM '95

NANCY HAVILAND  
REGISTER OF DEEDS  
LIVINGSTON COUNTY, MI  
48843

For corners in

Livingston  
(County)

Located In:

Corner Code #

- 1. Public Land Survey      T 3N    R 4E      D-13  
  T \_\_\_\_\_ R \_\_\_\_\_  
  T \_\_\_\_\_ R \_\_\_\_\_  
  T \_\_\_\_\_ R \_\_\_\_\_
- 2. Property Controlling    S \_\_\_\_\_ T \_\_\_\_\_ R \_\_\_\_\_  
   in Section                S \_\_\_\_\_ T \_\_\_\_\_ R \_\_\_\_\_
- 3. Miscellaneous            S \_\_\_\_\_ T \_\_\_\_\_ R \_\_\_\_\_  
   Property in Sec.         S \_\_\_\_\_ T \_\_\_\_\_ R \_\_\_\_\_

L. S. C. #439 m  
Register of Deeds Stamp & File Number

- 4. Lot No. \_\_\_\_\_, Recorded Plat \_\_\_\_\_
- 5. Private Claims \_\_\_\_\_

	A	B	C	D	E	F	G	H	I	J	K	L	M
2	6	5	4	3	2	1							
3													
4	7	8	9	10	11	12							
5													
6	18	17	16	15	14	13							
7													
8	19	20	21	22	23	24							
9													
10	30	29	28	27	26	25							
11													
12	31	32	33	34	35	36							
13													


Charles E Garlock, in a field survey on September 27, 1995, do hereby certify that under requirements of P.A. 74, Michigan P.A. of 1970, the corner points mentioned in lines 1 and 2 above were in conformance with regulations and rules therefore as required in the current manual of survey instructions of the United States Department of the Interior, Bureau of Land Management or by a decree of a Court of Law and/or that the corner points mentioned in lines 3, 4 and 5 above were in conformance with the rules of the Michigan Board of Land Surveyors or by a Decree of a Court of Law; established, re-established, monumented, re-monumented, recovered, found as expressed below:

NOTE: Not more than 4 corners, all in the same town and range, may be recorded on this certificate.

- A. Description of original monument and accessories and/or subsequent restoration:  
GLO survey dated: April 15, 1825 by S. Sibley DS  
GLO witness: W06-N55E-35 Lks  
W011-N68W- 101 lks

Additional historical data on rear of sheet

- B. Description of corner evidence found and/or method applied in restoring or reestablishing corner:  
Found a 1/2" X 3" I. rod set very near 1/2 distance between Section corners and on line with said Section corners.

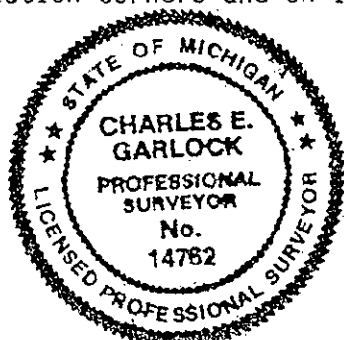

- C. Description of monument for corner and accessories established to perpetuate locating the position of the corner:  
D-13: South 1/4 cor. Section 32, T3N-R4E, Howell Twp, Liv. Co. MI, reset found iron with 1 1/4" X 36" breakaway I. Pipe with Liv. Co. Remon brass cap on top, set in a set Mon. Box at -0.5'  
S27W-32.26'-sp & tag E/s 20" Hickory  
S67W-110.09'-sp & tag N/s 24" Poplar  
N80W-89.92'-sp & tag S/s U. Pole  
N40E-30.11'-sp & tag S/s 12" Cherry  
N62E-68.71'-sp & tag S/s 12" Elm  
South-3.6'±- c/l Mason Road  
East-308.66'- N 1/4 cor. Sec. 5 Marion Twp.

Signed by Charles E Garlock Date September 27, 1995

Surveyor's Michigan License No. 14762