

SURVEY & REMONUMENTATION

OCT 21 1999

FILED

LAND CORNER RECORDATION CERTIFICATE
Filing Requirement of Act 74, Mich. P.A. 1970

SECTION

1998 AUG 20 P 4:41

NANCY HAVILAND
REGISTER OF DEEDS
LIVINGSTON COUNTY, MI.
48843

For corners in

LIVINGSTON
(County)

Located In:

Corner Code #

1. Public Land Survey

T3N R4NE E7 JD

T___ R___

T___ R___

T___ R___

2. Property Controlling in Section

S___ T___ R___

S___ T___ R___

3. Miscellaneous Property in Sec.

S___ T___ R___

S___ T___ R___

L.S.C. #850m

Register of Deeds Stamp & File Number

4. Lot No. _____, Recorded Plat _____

5. Private Claims _____

	A	B	C	D	E	F	G	H	I	J	K	L	M
1													
2	6		5		4		3		2		1		
3													
4	7		8		9		10		11		12		
5													
6	18		17		16		15		14		13		
7													
8	19		20		21		22		23		24		
9													
10	30		29		28		27		26		25		
11													
12	31		32		33		34		35		36		
13													


I, CHARLES E GARLOCK, in a field survey on Aug 8, 19 98 do hereby state that under requirements of P.A. 74, Michigan P.A. of 1970, the corner points mentioned in lines 1 and 2 above were in conformance with regulations and rules therefore as required in the current manual of survey instructions of the United States Department of the Interior, Bureau of Land Management or by a decree of a Court of Law and/or that the corner points mentioned in lines 3, 4 and 5 above were in conformance with the rules of the Michigan Board of Land Surveyors or by a Decree of a Court of Law; established, re-established, monumented, recovered, found as expressed below:

NOTE: Not more than 2 corners, all in the same town and range, may be recorded on this certificate.

A. Description of original monument and accessories and/or subsequent restoration:
GLO SURVEY DATED: APRIL 15, 1825 BY S SIBLEY, DS.
GLO WITNESSES: WO 25-N60W-13 LKS
RO 12-S41½E-25 LKS.

ADDITIONAL DATA ON REAR OF SHEET

B. Description of corner evidence found and/or method applied in restoring or reestablishing corner:
FOUND ½" I. ROD IN CENTERLINE OF ROADS 4 WAYS

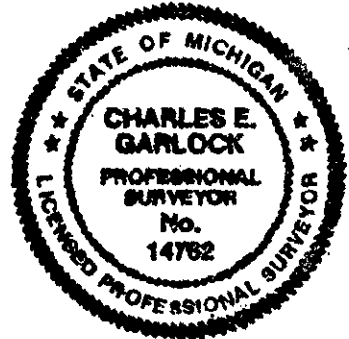

C. Description of monument for corner and accessories established to perpetuate locating the position of the corner:
E7: NW COR. SEC. 21, T3N-R4E, HOWELL TWP. LIV. CO. MI., RESET ½" I. ROD WITH 1¼" X 36" BREAK-AWAY I. PIPE WITH LIV. CO. REMON BRASS CAP ON TOP, IN A SET MON. BOX.
S85W-91.65'-SP & TAG N/S 16" HICKORY
S70W-160.66'-NE CORNER OF BRICK GARAGE
N30E-129.73'-SP & TAG N/S U. POLE
N15W-76.19'-SP & TAG E/S 6" SPRUCE
EAST-1'- CTR. BURKHART RPAD

Signed by Charles E. Garlock
Surveyor's Michigan License No. 14762

Date AUGUST 8, 1998

PA. 345 1990, APPROVED BY LIVINGSTON COUNTY
PEER GROUP ON 3/4/98 CO. REP _____

FORM APPROVED BY MICHIGAN STATE BOARD OF PROFESSIONAL SURVEYORS, JAN. 28, 1971
REVISED MAY 14, 1975
REVISED JAN., 1983
REVISED OCT., 1995