

SURVEY & REMONUMENTATION

FEB 25 1999

SECTION

LAND CORNER RECORDATION CERTIFICATE
Filing Requirement of Act 74, Mich. P.A. 1970

FILED

For corners in

<u>LIVINGSTON</u> (County)	Located In:	Corner Code #
1. Public Land Survey	T <u>3N</u> R <u>4E</u>	<u>E8</u>
	T___ R___	_____
	T___ R___	_____
	T___ R___	_____
2. Property Controlling in Section	S___ T___ R___	_____
	S___ T___ R___	_____
3. Miscellaneous Property in Sec.	S___ T___ R___	_____
	S___ T___ R___	_____

9' 1998 AUG 20 P 4:41

NANCY HAVILAND
REGISTER OF DEEDS
LIVINGSTON COUNTY, MI.
48843

L.S.C. #851m

Register of Deeds Stamp & File Number

4. Lot No. _____, Recorded Plat _____
5. Private Claims _____


I, CHARLES E GARLOCK, in a field survey on AUG 8, 19 98 do hereby state that under requirements of P.A. 74, Michigan P.A. of 1970, the corner points mentioned in lines 1 and 2 above were in conformance with regulations and rules therefore as required in the current manual of survey instructions of the United States Department of the Interior, Bureau of Land Management or by a decree of a Court of Law and /or that the corner points mentioned in lines 3, 4 and 5 above were in conformance with the rules of the Michigan Board of Land Surveyors or by a Decree of a Court of Law; established, re-established, monumented, recovered, found as expressed below:

	A	B	C	D	E	F	G	H	I	J	K	L	M	
1														
2	6			5			4			3			2	1
3														
4	7			8			9			10			11	12
5														
6	18			17			16			15			14	13
7														
8	19			20			21			22			23	24
9														
10	30			29			28			27			26	25
11														
12	31			32			33			34			35	36
13														

NOTE: Not more than 2 corners, all in the same town and range, may be recorded on this certificate.

A. Description of original monument and accessories and/or subsequent restoration:

GLO SURVEY DATED: APRIL 15, 1825, BY S SIBLEY
GLO WITNESSES: W028-S55W-5 LKS
HICKORY 10-S74E-32 LKS.

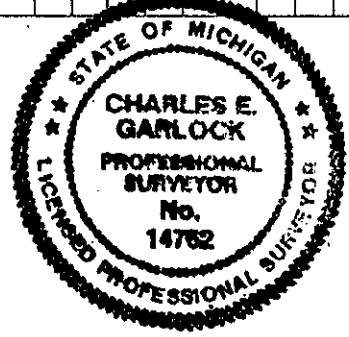

ADDITIONAL DATA ON REAR OF SHEET.

B. Description of corner evidence found and/or method applied in restoring or reestablishing corner:

FOUND 1/2" I. ROD WITH CAP, ON CENTERLINE OF ROAD NORTH & SOUTH AND ABOUT 6-7' NORTH OF BOWEN ROAD TO THE EAST, NO OCCUPATION TO THE WEST.

C. Description of monument for corner and accessories established to perpetuate locating the position of the corner:

E8: W 1/4 COR. SEC. 21 T3N-R4E, HOWELL TWP. LIV. CO. MI, RESET 1/2" I. ROD WITH 1 1/4" X 36" BREAKAWAY I. PIPE WITH LIV. CO. REMON. BRASS CAP ON TOP AND IN A SET MON. BOX.
N73W-73.03'-NE CORNER OF BRICK HOUSE
S70W-82.09'-SE CORNER OF BRICK HOUSE
S55E-64.57'-CTR. N'LY 2" STEEL POST AT NORTH ANGLE POINT IN FENCE
S40E-64.43'-CTR. S'LY 2" STEEL POST AT SOUTH ANGLE POINT IN FENCE
N80E-57.70'-CTR. OF UNDERGROUND CABLE MARKER

Signed by Charles E. Garlock
Surveyor's Michigan License No. 14762

Date AUGUST 8, 1998

PA. 345 1990, APPROVED BY LIVINGSTON COUNTY
PEER GROUP ON 3/18/98 CO. REP VED