

FEB 25 1999

SECTION

LAND CORNER RECORDATION CERTIFICATE  
Filing Requirement of Act 74, Mich. P.A. 1970

FILED

For corners in

LIVINGSTON

(County)

Located In:

Corner Code #

1. Public Land Survey

T 3N R 4E E9

2. Property Controlling in Section

S \_\_\_ T \_\_\_ R \_\_\_

3. Miscellaneous Property in Sec.

S \_\_\_ T \_\_\_ R \_\_\_  
S \_\_\_ T \_\_\_ R \_\_\_

4. Lot No. \_\_\_\_\_, Recorded Plat \_\_\_\_\_

5. Private Claims \_\_\_\_\_

91  
1998 AUG 20 P 4:41  
NANCY HAVILAND  
REGISTER OF DEEDS  
LIVINGSTON COUNTY, MI.  
48843

L.S.C. #852m

Register of Deeds Stamp & File Number

I, CHARLES E GARLOCK, in a field survey on AUG. 6, 1998 do hereby state that under requirements of P.A. 74, Michigan P.A. of 1970, the corner points mentioned in lines 1 and 2 above were in conformance with regulations and rules therefore as required in the current manual of survey instructions of the United States Department of the Interior, Bureau of Land Management or by a decree of a Court of Law and /or that the corner points mentioned in lines 3, 4 and 5 above were in conformance with the rules of the Michigan Board of Land Surveyors or by a Decree of a Court of Law; established, re-established, monumented, recovered, found as expressed below:

NOTE: Not more than 2 corners, all in the same town and range, may be recorded on this certificate.

A. Description of original monument and accessories and/or subsequent restoration:

GLO SURVEY DATED: APRIL 15, 1825 BY S SIBLEY, DS  
GLO WITNESSES: B06-S68½E-13 LKS  
W038-S46W-24 LKS

ADDITIONAL DATA ON REAR OF SHEET


B. Description of corner evidence found and/or method applied in restoring or reestablishing corner:

FOUND R.R. SPIKE 0.7' EAST OF ASPHALT ROAD CENTERLINE WITH TREE ROW TO THE WEST AND MOWED LAWN LINES TO THE EAST.

C. Description of monument for corner and accessories established to perpetuate locating the position of the corner:

E9: SW COR. SEC. 21, T3N-R4E, HOWELL TWP. LIV. CO. MI, RESET R.R. SPIKE WITH 1½" X 36" BREAKAWAY I, PIPE WITH LIV. CO. REMON BRASS CAP ON TOP IN A SET MON. BOX.  
N87E-32.36'-SP & TAG S/S U. POLE  
N66E-112.49'-SW CORNER BRICK GARAGE  
N77W-29.53'-SP & TAG S/S U. POLE  
N10W-91.68'-SP & TAG E/S 36" OAK  
WEST-1'-CTR. OF ROAD

1	A	B	C	D	E	F	G	H	I	J	K	L	M
2		6		5		4		3		2		1	
3													
4		7		8		9		10		11		12	
5													
6		16		17		16		15		14		13	
7													
8		19		20		21		22		23		24	
9													
10		30		29		28		27		26		25	
11													
12		31		32		33		34		35		36	
13													

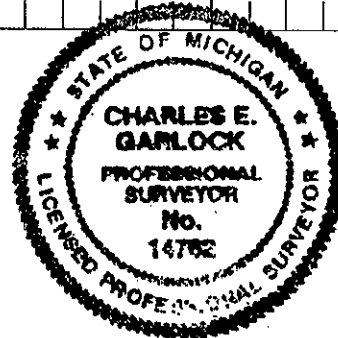

Signed by Charles E. Garlock  
Surveyor's Michigan License No. 14762

Date AUGUST 8, 1998