

SURVEY & REMONUMENTATION

FEB 25 1999

SECTION

LAND CORNER RECORDATION CERTIFICATE
Filing Requirement of Act 74, Mich. P.A. 1970

FILED

For corners in

<u>LIVINGSTON</u> (County)	Located In:	Corner Code #
1. Public Land Survey	T <u>3</u> N R <u>4</u> E	<u>E10</u>
	T <u> </u> R <u> </u>	<u> </u>
	T <u> </u> R <u> </u>	<u> </u>
	T <u> </u> R <u> </u>	<u> </u>
2. Property Controlling in Section	S <u> </u> T <u> </u> R <u> </u>	<u> </u>
	S <u> </u> T <u> </u> R <u> </u>	<u> </u>
3. Miscellaneous Property in Sec.	S <u> </u> T <u> </u> R <u> </u>	<u> </u>
	S <u> </u> T <u> </u> R <u> </u>	<u> </u>

1998 AUG 20 P 4:41
 NANCY HAVILAND
 REGISTER OF DEEDS
 LIVINGSTON COUNTY, MI.
 48843
 L.S.C. #853m
 Register of Deeds Stamp & File Number

4. Lot No. _____, Recorded Plat _____
 5. Private Claims _____

I, CHARLES E GARLOCK, in a field survey on AUG. 6, 1998 do hereby state that under requirements of P.A. 74, Michigan P.A. of 1970, the corner points mentioned in lines 1 and 2 above were in conformance with regulations and rules therefore as required in the current manual of survey instructions of the United States Department of the Interior, Bureau of Land Management or by a decree of a Court of Law and/or that the corner points mentioned in lines 3, 4 and 5 above were in conformance with the rules of the Michigan Board of Land Surveyors or by a Decree of a Court of Law; established, re-established, monumented, recovered, found as expressed below:

NOTE: Not more than 2 corners, all in the same town and range, may be recorded on this certificate.


A. Description of original monument and accessories and/or subsequent restoration:
 GLO SURVEY DATED: APRIL 15, 1825 BY S SIBLEY, DS
 GLO WITNESSES: W015-N89½E-86 LKS
 B030-N58W-46 LKS

ADDITIONAL DATA ON REAR OF SHEET

B. Description of corner evidence found and/or method applied in restoring or reestablishing corner:
 FOUND ½" I. ROD IN MON BOX, 2' SOUTH AND 2' EAST OF CENTERLINE INTERSECTION

C. Description of monument for corner and accessories established to perpetuate locating the position of the corner:
 E10: W¼ COR. SEC. 28 T3N-R4E, HOWELL TWP. LIV. CO. MI, RESET ½" I. ROD WITH 1¼" X36" BREAK-AWAY I. PIPE WITH LIV. CO. REMON. BRASS CAP ON TOP IN THE EXISTING MON. BOX.
 S60E-52.23'-SP & TAG N/S 18" MAPLE
 N71W-55.58'-SP & TAG S/S U. POLE
 N33W-111.64'-SE CORNER CONC. BLOCK BLDG.
 S74E-91.32'-SP & TAG N/S 18" MAPLE

1	A	B	C	D	E	F	G	H	I	J	K	L	M
2	6			5		4		3		2		1	
3													
4	7			8		9		10		11		12	
5													
6	10			17		16		15		14		13	
7													
8	19			20		21		22		23		24	
9													
10	30			29		28		27		26		25	
11													
12	31			32		33		34		35		36	
13													

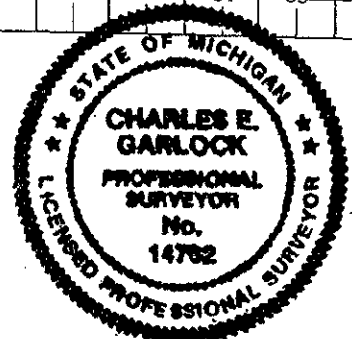

Signed by Charles E. Garlock
 Surveyor's Michigan License No. 14762

Date AUGUST 8, 1998

PA. 345 1990, APPROVED BY LIVINGSTON COUNTY
 PEER GROUP ON 3/4/98 CO. REP JED

LAND CORNER RECORDATION CERTIFICATE
Filing Requirement of Act 74, Mich. P.A. 1970

For corners in

<u>Livingston</u> (County)	Located In:	Corner Code \neq
1. Public Land Survey	T <u>3N</u> R <u>4E</u>	<u>E-11</u>
	T _____ R _____	_____
	T _____ R _____	_____
	T _____ R _____	_____
2. Property Controlling in Section	S _____ T _____ R _____	_____
	S _____ T _____ R _____	_____
3. Miscellaneous Property in Sec.	S _____ T _____ R _____	_____
	S _____ T _____ R _____	_____

SEP 1 3 28 PM '94
 NANCY HAVILAND
 REGISTER OF DEEDS
 LIVINGSTON COUNTY, MI
 48843

FILED

L.S.C.# 243m
 Register of Deeds Stamp & File Number

4. Lot No. _____, Recorded Plat _____
 5. Private Claims _____

Charles E Garlock, in a field survey on August 23, 19 94, do hereby certify that under requirements of P.A. 74, Michigan P.A. of 1970, the corner points mentioned in lines 1 and 2 above were in conformance with regulations and rules therefore as required in the current manual of survey instructions of the United States Department of the Interior, Bureau of Land Management or by a decree of a Court of Law and/or that the corner points mentioned in lines 3, 4 and 5 above were in conformance with the rules of the Michigan Board of Land Surveyors or by a Decree of a Court of Law; established, re-established, monumented, re-monumented, recovered, found as expressed below:

A	B	C	D	E	F	G	H	I	J	K	L	M
2	6	5	4	3	2	1						
3												
4	7	8	9	10	11	12						
5												
6	18	17	16	15	14	13						
7												
8	19	20	21	22	23	24						
9												
10	30	29	28	27	26	25						
11												
12	31	32	33	34	35	36						
13												

NOTE: Not more than 4 corners, all in the same town and range, may be recorded on this certificate.

A. Description of original monument and accessories and/or subsequent restoration:

GLO survey date: April 15, 1825 by S Sibley
 GLO witnesses: B0 8-S74E-0.59 ch
 0 12-S381/2E B0 12-S481/2E-0.65 ch

See additional data on rear of sheet

B. Description of corner evidence found and/or method applied in restoring or reestablishing corner:

Found 3/4" I. Pipe near centerline of Burkhart Road from previous witnesses
 Also found "T" steel fence post 4' long under the I. Pipe and located 0.17' South and 0.08' West of the above I. Pipe


**SURVEY &
 REMONUMENTATION**

SEP 26 1994

COMMISSION

C. Description of monument for corner and accessories established to perpetuate locating the position of the corner:

E-11: NW cor. Sec. 33 T3N-R4E, Howell Twp. Liv.Co. MI, reset "T" fence post with 1 1/4" X 36" I. Pipe with breakaway top and with a Liv. Co. Remon brass cap on top in a Mon Box
 West-214.89'-Sp N/s U Pole
 West-32.85'-1/2" I. Rod cap #26414
 West-1.5'±- ctr. Burkhart Rd.
 N15E-160.38'-Sp W/s & tag 6" Oak
 S80E-17.9'-ctr. Sign post
 S15W-121.85'-sp & tag W/s 7" Apple
 N45W-76.89'-sp & tag S/s 6" Cottonwood

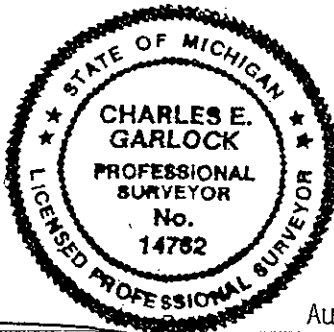

Signed by Charles E. Garlock
 Surveyor's Michigan License No. 14762

August 27, 1994