SURVEY & REMONUMENTATION

FEB 2 5 1999

SECTION

FILED

1998 AUG 20 P 4:42

NANCY HAVILAND
REGISTER OF DEEDS
LIVINGSTON COUNTY, MI.
48843

L.S.C. #856m

Register of Deeds Stamp & File Number

LAND CORNER RECORDATION CERTIFICATE

Filing Requirement of Act 74, Mich. P.A. 1970

For corners in

LIVINGSTON (County) Located In: Corner Code #

1. Public Land Survey		T3N R 4E	G9
		T___ R___	
		T___ R___	
		T___ R___	
2. Property Controlling	S___	T___ R___	
in Section	S___	T___ R___	
3. Miscellaneous	S___	T___ R___	
Property in Sec.	S___	T___ R___	

4. Lot No. _____ , Recorded Plat _____

5. Private Claims _____

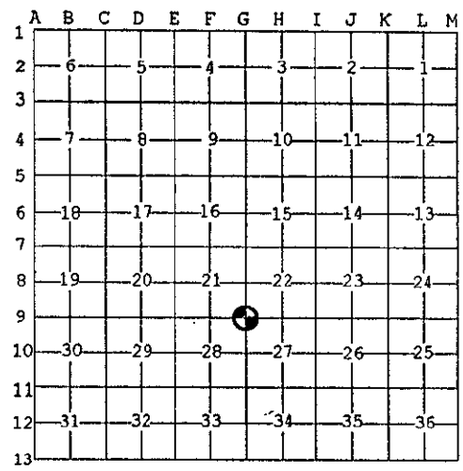

I, CHARLES E GARLOCK, in a field survey on AUG 5, 19 98 do hereby state that under requirements of P.A. 74, Michigan P.A. of 1970, the corner points mentioned in lines 1 and 2 above were in conformance with regulations and rules therefore as required in the current manual of survey instructions of the United States Department of the Interior, Bureau of Land Management or by a decree of a Court of Law and /or that the corner points mentioned in lines 3, 4 and 5 above were in conformance with the rules of the Michigan Board of Land Surveyors or by a Decree of a Court of Law; established, re-established, monumented, recovered, found as expressed below:

NOTE: Not more than 2 corners, all in the same town and range, may be recorded on this certificate.

A. Description of original monument and accessories and/or subsequent restoration:

GLO SURVEY DATED: APRIL 15, 1825 BY S SIBLEY, DS
GLO WITNESSES: WO 40-S76½E-51 LKS
WO 14-N59W-26 LKS.

]
]
ADDITIONAL DATA ON REAR OF SHEET

STATE OF MICHIGAN
CHARLES E. GARLOCK
PROFESSIONAL SURVEYOR
No. 14762
LICENSED PROFESSIONAL SURVEYOR

B. Description of corner evidence found and/or method applied in restoring or reestablishing corner:

FOUND ½" I. ROD 5' WEST OF CENTERLINE OF ROAD, REMAINS OF FENCE LINES EAST & WEST

C. Description of monument for corner and accessories established to perpetuate locating the position of the corner:

G9: SE COR. SEC. 21, T3N-R4E, HOWELL TWP. LIV. CO. MI, RESET 1/2" I. ROD WITH 1¼" X36" BREAKAWAY I. PIPE WITH LIV. CO. REMON BRASS CAP ON TOP.
N52E-36.32'- SP & TAG S/S 26" MAPLE
S54E-76.54'-SP & TAG N/S 8" MAPLE
N85W-26.08'-SP & TAG S/S 30" MAPLE
N39W-31.12'- SP & TAG E/S 10" MAPLE

Signed by Charles E. Garlock Date AUGUST 8, 1998

Surveyor's Michigan License No. 14762

P.A. 345 1990, APPROVED BY LIVINGSTON COUNTY PEER GROUP ON 3/4/98 CO. REP JED

FORM APPROVED BY MICHIGAN STATE BOARD OF PROFESSIONAL SURVEYORS, JAN. 28, 1971
REVISED MAY 14, 1975
REVISED JAN., 1983
REVISED OCT., 1995