

**SURVEY & REMONUMENTATION**

FEB 25 1999

**SECTION**

**LAND CORNER RECORDATION CERTIFICATE**  
Filing Requirement of Act 74, Mich. P.A. 1970

For corners in

LIVINGSTON  
(County)

Located In:

Corner Code #

- |                                    |              |              |             |
|------------------------------------|--------------|--------------|-------------|
| 1. Public Land Survey              | T <u>3</u> N | R <u>4</u> E | <u>H7</u>   |
|                                    | T <u>  </u>  | R <u>  </u>  | <u>  </u>   |
|                                    | T <u>  </u>  | R <u>  </u>  | <u>  </u>   |
|                                    | T <u>  </u>  | R <u>  </u>  | <u>  </u>   |
| 2. Property Controlling in Section | S <u>  </u>  | T <u>  </u>  | R <u>  </u> |
|                                    | S <u>  </u>  | T <u>  </u>  | R <u>  </u> |
| 3. Miscellaneous Property in Sec.  | S <u>  </u>  | T <u>  </u>  | R <u>  </u> |
|                                    | S <u>  </u>  | T <u>  </u>  | R <u>  </u> |

1998 JUN 11 P 1:50  
 NANCY HAVILAND  
 REGISTER OF DEEDS  
 LIVINGSTON COUNTY, MI.  
 48843

9- FILED

L.S.C.#847m

Register of Deeds Stamp & File Number

4. Lot No. \_\_\_\_\_, Recorded Plat \_\_\_\_\_  
 5. Private Claims \_\_\_\_\_

I, CHARLES E GARLOCK, in a field survey on JUNE 4, 1998 do hereby state that under requirements of P.A. 74, Michigan P.A. of 1970, the corner points mentioned in lines 1 and 2 above were in conformance with regulations and rules therefore as required in the current manual of survey instructions of the United States Department of the Interior, Bureau of Land Management or by a decree of a Court of Law and/or that the corner points mentioned in lines 3, 4 and 5 above were in conformance with the rules of the Michigan Board of Land Surveyors or by a Decree of a Court of Law; established, re-established, monumented, recovered, found as expressed below:

NOTE: Not more than 2 corners, all in the same town and range, may be recorded on this certificate.


	A	B	C	D	E	F	G	H	I	J	K	L	M
1													
2	6	5				4		3		2		1	
3													
4	7	8				9		10		11		12	
5													
6	18	17				16		15		14		13	
7													
8	19	20				21		22		23		24	
9													
10	30	29				28		27		26		25	
11													
12	31	32				33		34		35		36	
13													

- A. Description of original monument and accessories and/or subsequent restoration:  
 GLO SURVEY DATED: APRIL 15, 1825 BY S SIBLEY, DS  
 GLO WITNESSES: ELM 17-N70½E-98 LKS  
 ELM 22-S42½E-64 LKS

ADDITIONAL DATA ON REAR OF SHEET

- B. Description of corner evidence found and/or method applied in restoring or reestablishing corner:  
 FOUND ½" I. ROD NEXT TO WOOD POST, WITH FENCE LINES TO THE NORTH, SOUTH & EAST.  
 MARKED LS 19826 = PL BENTON

- C. Description of monument for corner and accessories established to perpetuate locating the position of the corner:  
 H7: N¼ COR. SEC. 22 T3N-R4E, HOWELL TWP. LIV. CO. MI, RESET ½" I. ROD WITH 1¼" X36" I. PIPE WITH LIV. CO. REMON BRASS CAP ON TOP.  
 N85E-26.58'-SP 18" MAPLE  
 S65E-10.10'-SP 10" ELM  
 N60W-29.41'-SP 7" ELM  
 S55W-50.52'-SP 20" BOX ELDER

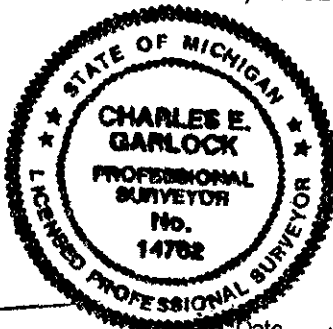

Signed by [Signature] Date JUNE 7, 1998  
 Surveyor's Michigan License No. 14762

PA. 345 1960, APPROVED BY LIVINGSTON COUNTY  
 PEER GROUP ON 4/1/98, CO. REP JED