

**SURVEY & REMONUMENTATION**

FEB 25 1999

SECTION

LAND CORNER RECORDATION CERTIFICATE  
Filing Requirement of Act 74, Mich. P.A. 1970

For corners in

Livingston  
(County)

Located In:

Corner Code #

1. Public Land Survey

T	3N	R	4E	H9
T		R		
T		R		
T		R		
S		T		
S		T		
S		T		
S		T		

2. Property Controlling in Section

3. Miscellaneous Property in Sec.

4. Lot No. \_\_\_\_\_, Recorded Plat \_\_\_\_\_  
5. Private Claims \_\_\_\_\_

NANCY HAVILL AND  
REGISTER OF DEEDS  
LIVINGSTON COUNTY, MI.  
48843

1998 JUN 11 P 1:49

FILED

L.S.C. #848m  
Register of Deeds Stamp & File Number

I, CHARLES E. GARLOCK, in a field survey on APRIL 20, 1998 do hereby state that under requirements of P.A. 74, Michigan P.A. of 1970, the corner points mentioned in lines 1 and 2 above were in conformance with regulations and rules therefore as required in the current manual of survey instructions of the United States Department of the Interior, Bureau of Land Management or by a decree of a Court of Law and/or that the corner points mentioned in lines 3, 4 and 5 above were in conformance with the rules of the Michigan Board of Land Surveyors or by a Decree of a Court of Law; established, re-established, monumented, recovered, found as expressed below:

NOTE: Not more than 2 corners, all in the same town and range, may be recorded on this certificate.

	A	B	C	D	E	F	G	H	I	J	K	L	M
1													
2	6		5		4		3		2		1		
3													
4	7		8		9		10		11		12		
5													
6	10		17		16		15		14		13		
7													
8	19		20		21		22		23		24		
9													
10	30		29		28		27		26		25		
11													
12	31		32		33		34		35		36		
13													

A. Description of original monument and accessories and/or subsequent restoration:  
 GLO SURVEY DATED APRIL 15, 1825 BY S. SIBLEY, DS,  
 GLO WITNESSES WILLOW 5 S48E 38 LKS  
 ASPIN 8 N75W 115 LKS

ADDITIONAL INFORMATION ON REAR OF SHEET.

B. Description of corner evidence found and/or method applied in restoring or reestablishing corner:


FOUND A 1/2" I. ROD WITH PL BENTON CAP AT -1.5' AND ABOUT 4' EAST OF EAST OF OF RIVER WITH REMAINS OF FENCE LINE TO THE EAST AND EVEN LESS REMAINS TO THE WEST.

C. Description of monument for corner and accessories established to perpetuate locating the position of the corner:

H9; S 1/4 COR. SEC. 22 T3N-R4E, HOWELL TWP. LIV. CO. MI, RESET 1/2" I. ROD WITH 1 1/4" X 36" I. PIPE WITH LIV. CO. REMON BRASS CAP ON TOP.  
 S20W-17.65'- SP W/S 10" CHERRY  
 S03W-36.83'-SP W/S 8" ELM  
 S35E-38.19'-SP S/S 18" ELM  
 N70E-49.07'-SP S/S 14" ELM

Signed by Charles E. Garlock  
 Surveyor's Michigan License No. 14762

Date APRIL 20, 1998

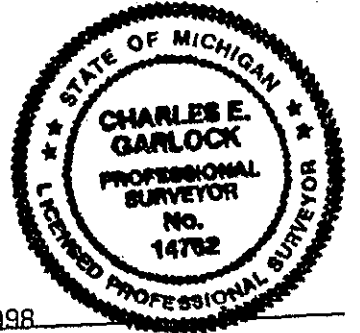

PA. 243 1980, APPROVED BY LIVINGSTON COUNTY  
 PEER GROUP ON 4-1-98 CO. REP JED

**LAND CORNER RECORDATION CERTIFICATE**  
**Filing Requirement of Act 74, Mich. P.A. 1970**

For corners in

Livingston  
(County)

Located In:

Corner Code **##**

1. Public Land Survey	T <u>3N</u> R <u>4E</u>	<u>H-11</u>
	T _____ R _____	_____
	T _____ R _____	_____
	T _____ R _____	_____
2. Property Controlling in Section	S _____ T _____ R _____	_____
	S _____ T _____ R _____	_____
3. Miscellaneous Property in Sec.	S _____ T _____ R _____	_____
	S _____ T _____ R _____	_____

SEP 1 3 29 PM '94  
 NANCY HAVILLAND  
 REGISTER OF DEEDS  
 LIVINGSTON COUNTY, MI  
 48843

FILED

L.S.C.# 248m  
 Register of Deeds Stamp & File Number

4. Lot No. \_\_\_\_\_, Recorded Plat \_\_\_\_\_  
 5. Private Claims \_\_\_\_\_

	A	B	C	D	E	F	G	H	I	J	K	L	M
2	6	5	4	3	2	1							
3													
4	7	8	9	10	11	12							
5													
6	18	17	16	15	14	13							
7													
8	19	20	21	22	23	24							
9													
10	30	29	28	27	26	25							
11													
12	31	32	33	34	35	36							
13													

I, Charles E Garlock, in a field survey on August 18, 19 94

do hereby certify that under requirements of P.A. 74, Michigan P.A. of 1970, the corner points mentioned in lines 1 and 2 above were in conformance with regulations and rules therefore as required in the current manual of survey instructions of the United States Department of the Interior, Bureau of Land Management or by a decree of a Court of Law and/or that the corner points mentioned in lines 3, 4 and 5 above were in conformance with the rules of the Michigan Board of Land Surveyors or by a Decree of a Court of Law; established, re-established, monumented, re-monumented, recovered, found as expressed below:

**NOTE: Not more than 4 corners, all in the same town and range, may be recorded on this certificate.**

A. Description of original monument and accessories and/or subsequent restoration:  
 GL0 survey date: April 15, 1825, by S Sibley, DS  
 GL0 witnesses: Aspin 12-S19W-1.11 ch  
 BO 9-N4E-1.28ch.


Additional data on rear of sheet

B. Description of corner evidence found and/or method applied in restoring or reestablishing corner:  
 Found 2" dia Steel post set in concrete, very old. with round steel ball on top

**SURVEY & REMONUMENTATION**

SEP 26 1994

COMMISSION

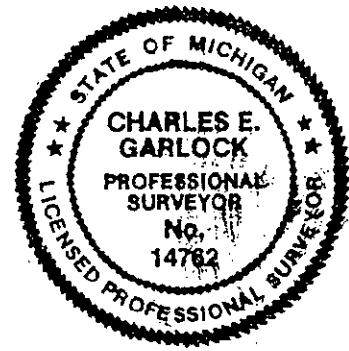

C. Description of monument for corner and accessories established to perpetuate locating the position of the corner:  
 H-11: North 1/4 cor. Sec. 34 T3N-R4E, Howell Twp. Liv. Co. MI, left found 2" Steel post in place.  
 North-1/61'-sp & tag W/s 20" Elm  
 S45W-11.36'-1" X 36" I. pipe with Liv. Co. Remon Witness brass cap on top  
 N60W-11.40'-1" X 36" I. Pipe with Liv. Co. Remon Witness brass cap on top  
 S80E-27.68'-sp & tag S/s 16" thornless Locust  
 East-2.80'-face of 2" X 2" angle steel fenc post

Signed by Charles E. Garlock Date August 19, 1994  
 Surveyor's Michigan License No. 14762