

SURVEY & REMONUMENTATION

FEB 25 1999

91

SECTION

LAND CORNER RECORDATION CERTIFICATE
Filing Requirement of Act 74, Mich. P.A. 1970

For corners in

LIVINGSTON
(County)

Located in:

Corner Code #

- | | | | |
|------------------------------------|--------------|--------------|-----------|
| 1. Public Land Survey | T <u>3</u> N | R <u>4</u> E | <u>17</u> |
| | T | R | |
| | T | R | |
| | T | R | |
| 2. Property Controlling in Section | S | T | R |
| | S | T | R |
| 3. Miscellaneous Property in Sec. | S | T | R |
| | S | T | R |

1998 JUN 11 P 1:50
RANCY HAYLAND
REGISTER OF DEEDS
LIVINGSTON COUNTY, MI.
48843

FILED

L. SEC. #849m

Register of Deeds Stamp & File Number

4. Lot No. _____, Recorded Plat _____
5. Private Claims _____

I, CHARLES E. GARLOCK, in a field survey on JUNE 4, 1998 do hereby state that under requirements of P.A. 74, Michigan P.A. of 1970, the corner points mentioned in lines 1 and 2 above were in conformance with regulations and rules therefore as required in the current manual of survey instructions of the United States Department of the Interior, Bureau of Land Management or by a decree of a Court of Law and /or that the corner points mentioned in lines 3, 4 and 5 above were in conformance with the rules of the Michigan Board of Land Surveyors or by a Decree of a Court of Law; established, re-established, monumented, recovered, found as expressed below:

NOTE: Not more than 2 corners, all in the same town and range, may be recorded on this certificate.

	A	B	C	D	E	F	G	H	I	J	K	L	M
1													
2	6		5		4		3		2		1		
3													
4	7		8		9		10		11		12		
5													
6	18		17		16		15		14		13		
7													
8	19		20		21		22		23		24		
9													
10	30		29		28		27		26		25		
11													
12	31		32		33		34		35		36		
13													

A. Description of original monument and accessories and/or subsequent restoration:

GLO SURVEY DATED: APRIL 15, 1825, BY S SIBLEY, DS
GLO WITNESSES: WO 31-S65E-66½ LKS
BO 11-S48½W-83 LKS


ADDITIONAL DATA ON REAR OF SHEET

B. Description of corner evidence found and/or method applied in restoring or reestablishing corner:

FOUND ½" I. ROD WITH BENTON CAP, OLD FENCE LINE TO THE EAST AND NORTH-SOUTH FENCE LINE RUNNING 4.5' EAST OF IRON.

C. Description of monument for corner and accessories established to perpetuate locating the position of the corner:

I7: NE COR. SEC. 22, T3N-R4E, HOWELL TWP. LIV. CO. MI, RESET ½" I. ROD WITH 1½" X 36" I. PIPE WITH LIV. C O. REMON BRASS CAP ON TOP .
EAST-8.41'-SP 28" OAK
N31E-65.68'-SP 28" OAK
S31E-23.41'-SP 14" OAK
N43W-17.96'-SP 12" OAK

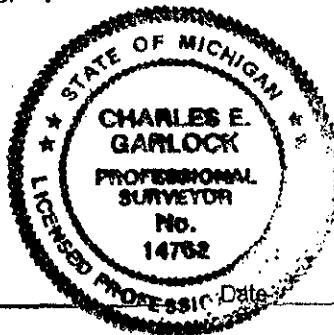

Signed by [Signature]
Surveyor's Michigan License No. 14762

JUNE 8, 1998