

## CORNER SUMMARY

1-10: WEST 1/4 CORNER OF SECTION 26, T3N-R4E, HOWELL TOWNSHIP,  
LIVINGSTON COUNTY, MICHIGAN.

GLO SURVEY DATED APRIL 15, 1825 BY S SIBLEY, DS, AND NONE OF THE  
GLO WITNESSES REMAIN.

IN 1870 M BULLOCK WITNESSED THIS CORNER AND NONE OF THE WITNESSES  
REMAIN. NEXT KNOWN ACTIVITY WAS IN 1954 WHEN L MUNSELL FOUND A  
3/4" I. ROD AND RAISED IT WITH A 1/2" I. ROD, NONE OF HIS  
WITNESSES REMAIN BECAUSE OF THE NEW CONSTRUCTION OF M-59. SINCE  
1968 SURVEYORS HAVE FOUND THE 1/2" I. ROD, SOME CALL IT A 3/8" I.  
ROD AND WITNESSES THAT REMAIN CHECK TODAY. THE SURVEYORS ARE L  
MUNSELL, BOSS ENGR, P BENTON, DESINE, WASH. ENGR. AND MYSELF.  
FOUND THREE ACT 74'S RECORDED AND TEN ACT 132'S. MEASURES NORTH  
ARE 2658.79 BY DESINE, 2659.20 BY WASH ENGR. AND 2658.77 BY BOSS  
ENGR.; MEASURES EAST ARE 2665.64 BY DESINE AND 2665.55 BY BOSS  
ENGR.; MEASURE SOUTH 2659.73 BY BOSS ENGR. AND 2659.95 BY MYSELF  
CORNER LINES WITH THE OLD REMAINS OF HIGHLAND ROAD TO THE WEST,  
BUT REMAINS TO THE EAST ARE GONE; LINES WITH BREWER ROAD TO THE  
NORTH AND A FENCE LINE TO THE SOUTH. CORNER IS LOCATED IN THE  
GRAVEL PORTION OF BREWER ROAD AND IS SUITABLE FOR GPS.  
RECOMMEND THE FOUND 1/2" I. ROD BE USED FOR SAID CORNER AND FOUND  
NO OTHER IRONS IN THE AREA.



CHARLES E GARLOCK  
PS 14762  
HOW96110

3N4E I-10

4

OCT 25 1993

Oct 12 10 10 AM '93

COMMISSION

LAND CORNER RECORDATION CERTIFICATE  
Filing Requirement of Act 74, Mich. P.A. 1970

NANCY HAYLAND  
REGISTER OF DEEDS  
LIVINGSTON COUNTY, MI  
48843

For corners in  
Livingston  
(County)

Located In: Corner Code ##

- 1. Public Land Survey T 3N R 4E I - 11  
T \_\_\_\_\_ R \_\_\_\_\_  
T \_\_\_\_\_ R \_\_\_\_\_  
T \_\_\_\_\_ R \_\_\_\_\_
- 2. Property Controlling S \_\_\_\_\_ T \_\_\_\_\_ R \_\_\_\_\_  
in Section S \_\_\_\_\_ T \_\_\_\_\_ R \_\_\_\_\_
- 3. Miscellaneous S \_\_\_\_\_ T \_\_\_\_\_ R \_\_\_\_\_  
Property in Sec. S \_\_\_\_\_ T \_\_\_\_\_ R \_\_\_\_\_
- 4. Lot No. \_\_\_\_\_, Recorded Plat \_\_\_\_\_
- 5. Private Claims \_\_\_\_\_

L.S.C.# 16m

Register of Deeds Stamp & File Number

I, Charles E Garlock, in a field survey on October 8, 19 93, do hereby certify that under requirements of P.A. 74, Michigan P.A. of 1970, the corner points mentioned in lines 1 and 2 above were in conformance with regulations and rules therefore as required in the current manual of survey instructions of the United States Department of the Interior, Bureau of Land Management or by a decree of a Court of Law and/or that the corner points mentioned in lines 3, 4 and 5 above were in conformance with the rules of the Michigan Board of Land Surveyors or by a Decree of a Court of Law; established, re-established, monumented, re-monumented, recovered, found as expressed below:

NOTE: Not more than 4 corners, all in the same town and range, may be recorded on this certificate.

- A. Description of original monument and accessories and/or subsequent restoration:  
GLO notes dated: April 15, 1825  
GLO witnesses: WO 11-S64E-18 lks  
WO 13-N45W-28 lks

Additional historical data on back of sheet


- B. Description of corner evidence found and/or method applied in restoring or reestablishing corner:  
Found remains of 2" Well point laying on ground near by, which was removed by recent reconstruction of Highlanderway. Re-established corner using survey notes of Walton Newton PS, Liv. Co. Rd. Comm. Surveyor dated 8-26-92 between I-11 and I-10 ALSO survey data from recorded Act 74 by A Butterfield. PS, LSC #1451 between I-11 and I-12 re-established point matched the 2 remaining witnesses by A Butterfield.

- C. Description of monument for corner and accessories established to perpetuate locating the position of the corner:  
Set 1 1/4" X 42" breakaway I. Pipe with brass cap (-0.5')  
N5W-59.48'-sp W/s U Pole  
N20W-20.97'-centerline top of Fire Hydrant  
South-24.72'-sp W/s 7" Box Elder  
N75E-26.45'-SW corner, backside, of Catch Basin

Approved by Livingston County Monumentation Peer Group August 18, 1993

Signed by Charles E Garlock Date October 9, 1993

Surveyor's Michigan License No. 14762

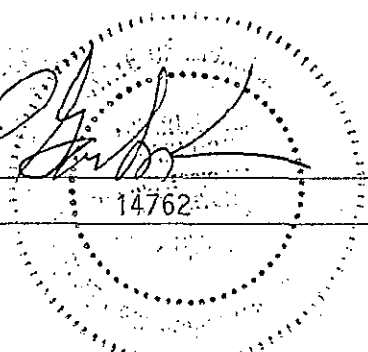

	A	B	C	D	E	F	G	H	I	J	K	L	M
2	6	5	4	3	2	1							
3													
4	7	8	9	10	11	12							
5													
6	18	17	16	15	14	13							
7													
8	19	20	21	22	23	24							
9													
10	30	29	28	27	26	25							
11													
12	31	32	33	34	35	36							
13													

10/26/93