

CORNER SUMMARY

J-9: N 1/4 CORNER SECTION 26, T3N-R4E, HOWELL TOWNSHIP,
LIVINGSTON COUNTY, MICHIGAN.

GLO SURVEY DATED APRIL 15, 1825 BY S SIBLEY, DS, AND NONE OF THE
GLO WITNESSES REMAIN.

M BULLOCK WITNESSED THIS CORNER IN 1879 AND NONE REMAIN. IN 1950
AND 1955 C GORDON AND L MUNSELL HAD THE SAME WITNESSES TO A 3/4"
SQUARE IRON, ONE REMAINS AND IT CHECKS. IN 1973 P BENTON'S
WITNESSES CHECKED WITH A SECOND ONE OF GORDON'S AND MUNSELL'S AND
TWO OF P BENTON'S REMAINING WITNESSES CHECK TODAY. SINCE THEN
MANY OF THE WITNESSES BY DESINE, GIFFELS-WEBSTER AND MYSELF CHECK.
TWO ACT 74'S ARE RECORDED AND TWO ACT 132'S. MEASURES TO THE WEST
ARE 2653.92 BY DESINE, 2653.88 BY BOSS AND 2653.93 BY MYSELF;
MEASURE SOUTH 2653.17 BY DESINE; MEASURES EAST 2643.93 BY BENTON
AND 2643.88 BY BOSS AND MEASURES NORTH 2662.56 BY BOSS AND 2662.62
BY MYSELF. THE FOUND 3/4" I. PIPE LINES WITH CENTERLINE OF ROADS
TO NORTH, EAST AND WEST AND IS LOCATED ABOUT ONE FOOT EAST OF THE
WEST EDGE OF THE ASPHALT PAVEMENT OF BYRON ROAD. SITE IS NOT
SUITABLE FOR GPS BECAUSE OF THE SURROUNDING LARGE TREES. RECOMMEND
WE CONTINUE TO USE THE CORNER AS FOUND AND FOUND NO OTHER IRONS IN
THE AREA.



CHARLES E GARLOCK
PS 14762
HOW96J9

T3N R4E J9
4

FILED

LAND CORNER RECORDATION CERTIFICATE
Filing Requirement of Act 74, Mich. P.A. 1970

AUG 8 12 56 PM '94

For corners in

Livingston
(County)

Located In:

Corner Code #/

- 1. Public Land Survey T 3N R 4E J-11
 T _____ R _____
 T _____ R _____
 T _____ R _____
- 2. Property Controlling S _____ T _____ R _____
 in Section S _____ T _____ R _____
- 3. Miscellaneous S _____ T _____ R _____
 Property in Sec. S _____ T _____ R _____
- 4. Lot No. _____, Recorded Plat _____
- 5. Private Claims _____

NANCY HAVILANG
REGISTER OF DEEDS
LIVINGSTON COUNTY, MI
48843

L.S.C.#199m

Register of Deeds Stamp & File Number

	A	B	C	D	E	F	G	H	I	J	K	L	M
2	6	5	4	3	2	1							
3													
4	7	8	9	10	11	12							
5													
6	13	17	16	15	14	13							
7													
8	19	20	21	22	23	24							
9													
10	30	29	28	27	26	25							
11													
12	31	32	33	34	35	36							
13													

I, Charles E Garlock, in a field survey on June 7, 19 94, do hereby certify that under requirements of P.A. 74, Michigan P.A. of 1970, the corner points mentioned in lines 1 and 2 above were in conformance with regulations and rules therefore as required in the current manual of survey instructions of the United States Department of the Interior, Bureau of Land Management or by a decree of a Court of Law and/or that the corner points mentioned in lines 3, 4 and 5 above were in conformance with the rules of the Michigan Board of Land Surveyors or by a Decree of a Court of Law; established, re-established, monumented, re-monumented, recovered, found as expressed below:

NOTE: Not more than 4 corners, all in the same town and range, may be recorded on this certificate.

A. Description of original monument and accessories and/or subsequent restoration:

GLO survey date: April 15, 1825 by S Sibley, DS
GLO witnesses: Aspin 6-N37E-0.20ch
Elm 7-South-0.32 ch

See additional data on rear of sheet

B. Description of corner evidence found and/or method applied in restoring or reestablishing corner:


Found 3/4" I. Pipe from old witnesses and recorded Act 74's

SURVEY &
REMONUMENTATION

SEP 26 1994

COMMISSION

- C. Description of monument for corner and accessories established to perpetuate locating the position of the corner:
 J-11: N 1/4 cor. Sec. 35, T3N-R4E, Howell Twp. Liv. Co. MI, set 1 1/4" X 36" I. Pipe with Liv. Co. Remon. brass cap in place of found 3/4" I. Pipe at +0.3'
 N85W-12.79'-sp & tag N/s 49" Oak
 N80W-18.10'-sp & tag S/s 30" Oak
 N45W-8.97'-sp & tag E/s 32" Oak
 N10W-31.18'-sp & tag E/s 53" Oak
 East-20.95'-sp & tag N/s multi 5" Crab Apples

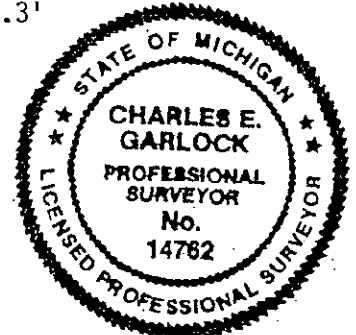

Signed by Charles E. Garlock Date August 3, 1994

Surveyor's Michigan License No. 14762