

SURVEY & REMONUMENTATION

FILED

OCT 25 1993

Oct 18 9 18 AM '93

LAND CORNER RECORDATION CERTIFICATE
Filing Requirement of Act 74, Mich. P.A. 1970

NANCY HAVILAND
REGISTER OF DEEDS
LIVINGSTON COUNTY, MI
48843

COMMISSION

For corners in

Livingston
(County)

Located In:

Corner Code J-13

1. Public Land Survey	T <u>3N</u> R <u>4E</u>	<u>J-13</u>
	T _____ R _____	_____
	T _____ R _____	_____
	T _____ R _____	_____
2. Property Controlling in Section	S _____ T _____ R _____	_____
	S _____ T _____ R _____	_____
3. Miscellaneous Property in Sec.	S _____ T _____ R _____	_____
	S _____ T _____ R _____	_____

C.L.S.# 22m

Register of Deeds Stamp & File Number

4. Lot No. _____, Recorded Plat _____
5. Private Claims _____

	A	B	C	D	E	F	G	H	I	J	K	L	M
2	6	5	4	3	2	1							
3													
4	7	8	9	10	11	12							
5													
6	16	17	18	15	14	13							
7													
8	19	20	21	22	23	24							
9													
10	30	29	28	27	26	25							
11													
12	31	32	33	34	35	36							
13													

I, Charles E. Garlock, in a field survey on October 15, 19 93, do hereby certify that under requirements of P.A. 74, Michigan P.A. of 1970, the corner points mentioned in lines 1 and 2 above were in conformance with regulations and rules therefore as required in the current manual of survey instructions of the United States Department of the Interior, Bureau of Land Management or by a decree of a Court of Law and/or that the corner points mentioned in lines 3, 4 and 5 above were in conformance with the rules of the Michigan Board of Land Surveyors or by a Decree of a Court of Law; established, re-established, monumented, re-monumented, recovered, found as expressed below:

NOTE: Not more than 4 corners, all in the same town and range, may be recorded on this certificate.

A. Description of original monument and accessories and/or subsequent restoration:
GLO notes dated: April 15, 1825
GLO witnesses: WO 34-N73E-48 lks
WO 14-N36W-5 lks


Additional historical data on back of sheet

B. Description of corner evidence found and/or method applied in restoring or reestablishing corner:
This corner was set on a straight line between the SW corner of Section 35 and the SE corner of Section 35 at 1/2 the distance of the entire mile.
NOTE: ACT 74 recorded in L.S.C. No. 625 dated May 9, 1973 and labelled J-13 of T3N-R4E was actually witnessing corner J-1' of T2N-R4E.

C. Description of monument for corner and accessories established to perpetuate locating the position of the corner:
J-13, South 1/4 corner Section 35, T3N-R4E, Set 11/4" X 36" breakaway I. Pipe with Brass cap (Liv. Co. Mon. Cor.) in Mon. box.
S51-53E-104.06'-Spike E/s U. Pole
S69-34E-220.31'-sp W/s 18" Pine
N72-51E-202.50'-spike N-s U, Pole
N67-31E-61.93'-spike top of most Easterly wood guard rail post (North/s Road) 1/4 corner on the centerline of Mason Road.

Approved by Livingston County
Monumentation Peer Group
August 18, 1993

Signed by Charles E. Garlock

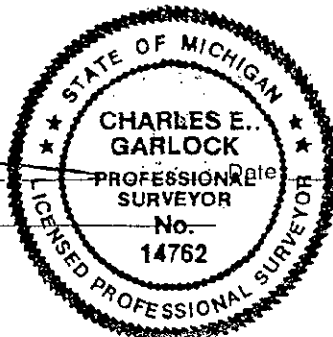

Surveyor's Michigan License No. 14762

October 16, 1993

10/26/93