

MAR 17 2000

FILED

SECTION

LAND CORNER RECORDATION CERTIFICATE  
Filing Requirement of Act 74, Mich. P.A. 1970

1999 MAY 21 A 9:22

For corners in

<u>LIVINGSTON</u> (County)	Located In:	Corner Code #
1. Public Land Survey	<u>T3N R4E</u>	<u>K-04</u>
	T ___ R ___	_____
	T ___ R ___	_____
	T ___ R ___	_____
2. Property Controlling in Section	S ___ T ___ R ___	_____
	S ___ T ___ R ___	_____
3. Miscellaneous Property in Sec.	S ___ T ___ R ___	_____
	S ___ T ___ R ___	_____

NANCY HAVILAND  
REGISTER OF DEEDS  
LIVINGSTON COUNTY, MI.  
48843

L.S.C. #1008m

Register of Deeds Stamp & File Number

4. Lot No. \_\_\_\_\_, Recorded Plat \_\_\_\_\_  
5. Private Claims \_\_\_\_\_

A	B	C	D	E	F	G	H	I	J	K	L	M
1												
2	6	5	4	3	2	1						
3												
4	7	8	9	10	11	12						
5												
6	18	17	16	15	14	13						
7												
8	19	20	21	22	23	24						
9												
10	30	29	28	27	26	25						
11												
12	31	32	33	34	35	36						
13												

I, JACK K SMITH, in a field survey on APRIL 30, 1999 do hereby state that under requirements of P.A. 74, Michigan P.A. of 1970, the corner points mentioned in lines 1 and 2 above were in conformance with regulations and rules therefore as required in the current manual of survey instructions of the United States Department of the Interior, Bureau of Land Management or by a decree of a Court of Law and/or that the corner points mentioned in lines 3, 4 and 5 above were in conformance with the rules of the Michigan Board of Land Surveyors or by a Decree of a Court of Law; established, re-established, monumented, recovered, found as expressed below:

NOTE: Not more than 2 corners, all in the same town and range, may be recorded on this certificate.

A. Description of original monument and accessories and/or subsequent restoration:

GLO 1825 SIBLEY SET POST  
WHITE OAK 7 N 67° E 18.5'  
WHITE OAK 8 N 86° W 21.1'

B. Description of corner evidence found and/or method applied in restoring or reestablishing corner:


FOUND BOAT SPIKE IN MONUMENT BOX FROM PREVIOUS WITNESSES. THIS POSITION IS THE ONLY ONE THAT APPEARS TO HAVE BEEN USED.

C. Description of monument for corner and accessories established to perpetuate locating the position of the corner:

K-04 EAST 1/4 CORNER SECTION 11 AND WEST 1/4 CORNER SECTION 12, T3N, R4E, HOWELL TOWNSHIP, LIVINGSTON COUNTY, MICHIGAN:

SET 1 1/4" X 36" STEEL PIPE WITH 6" BREAK OFF SECTION AND LIVINGSTON COUNTY REMONUMENTATION BRASS CAP WITH SURVEYOR #35999 IN MONUMENT BOX 2 FEET WEST OF CENTER LINE OF OAK GROVE ROAD.

- S58°E NAIL WITH LIVINGSTON COUNTY REMON TAG IN SOUTH SIDE UTILITY POLE 165.52'
- S42°E NAIL WITH LIVINGSTON COUNTY REMON TAG IN 4" X 6" WOODEN SIGN POST 81.74'
- S45°W NAIL WITH LIVINGSTON COUNTY REMON TAG IN NORTH SIDE UTILITY POLE 42.15'
- S84°W NAIL WITH LIVINGSTON COUNTY REMON TAG IN NORTH SIDE 15" POPLAR 104.48'
- S85°W NAIL WITH LIVINGSTON COUNTY REMON TAG IN NORTH SIDE 36" HICKORY 166.24'

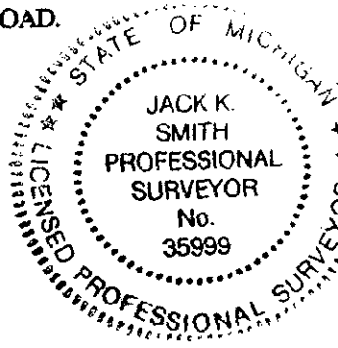

Signed by

*[Signature]*

Date

5-11-1999

Surveyor's Michigan License No. 35999

PA. 345 1990, APPROVED BY LIVINGSTON COUNTY  
PEER GROUP ON 4-7-99 CO REP LED